
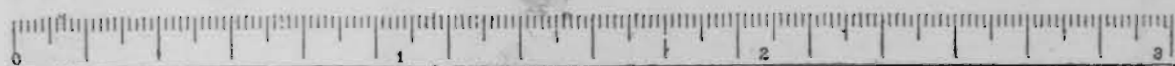


Township 38,

Range 2W W.M.

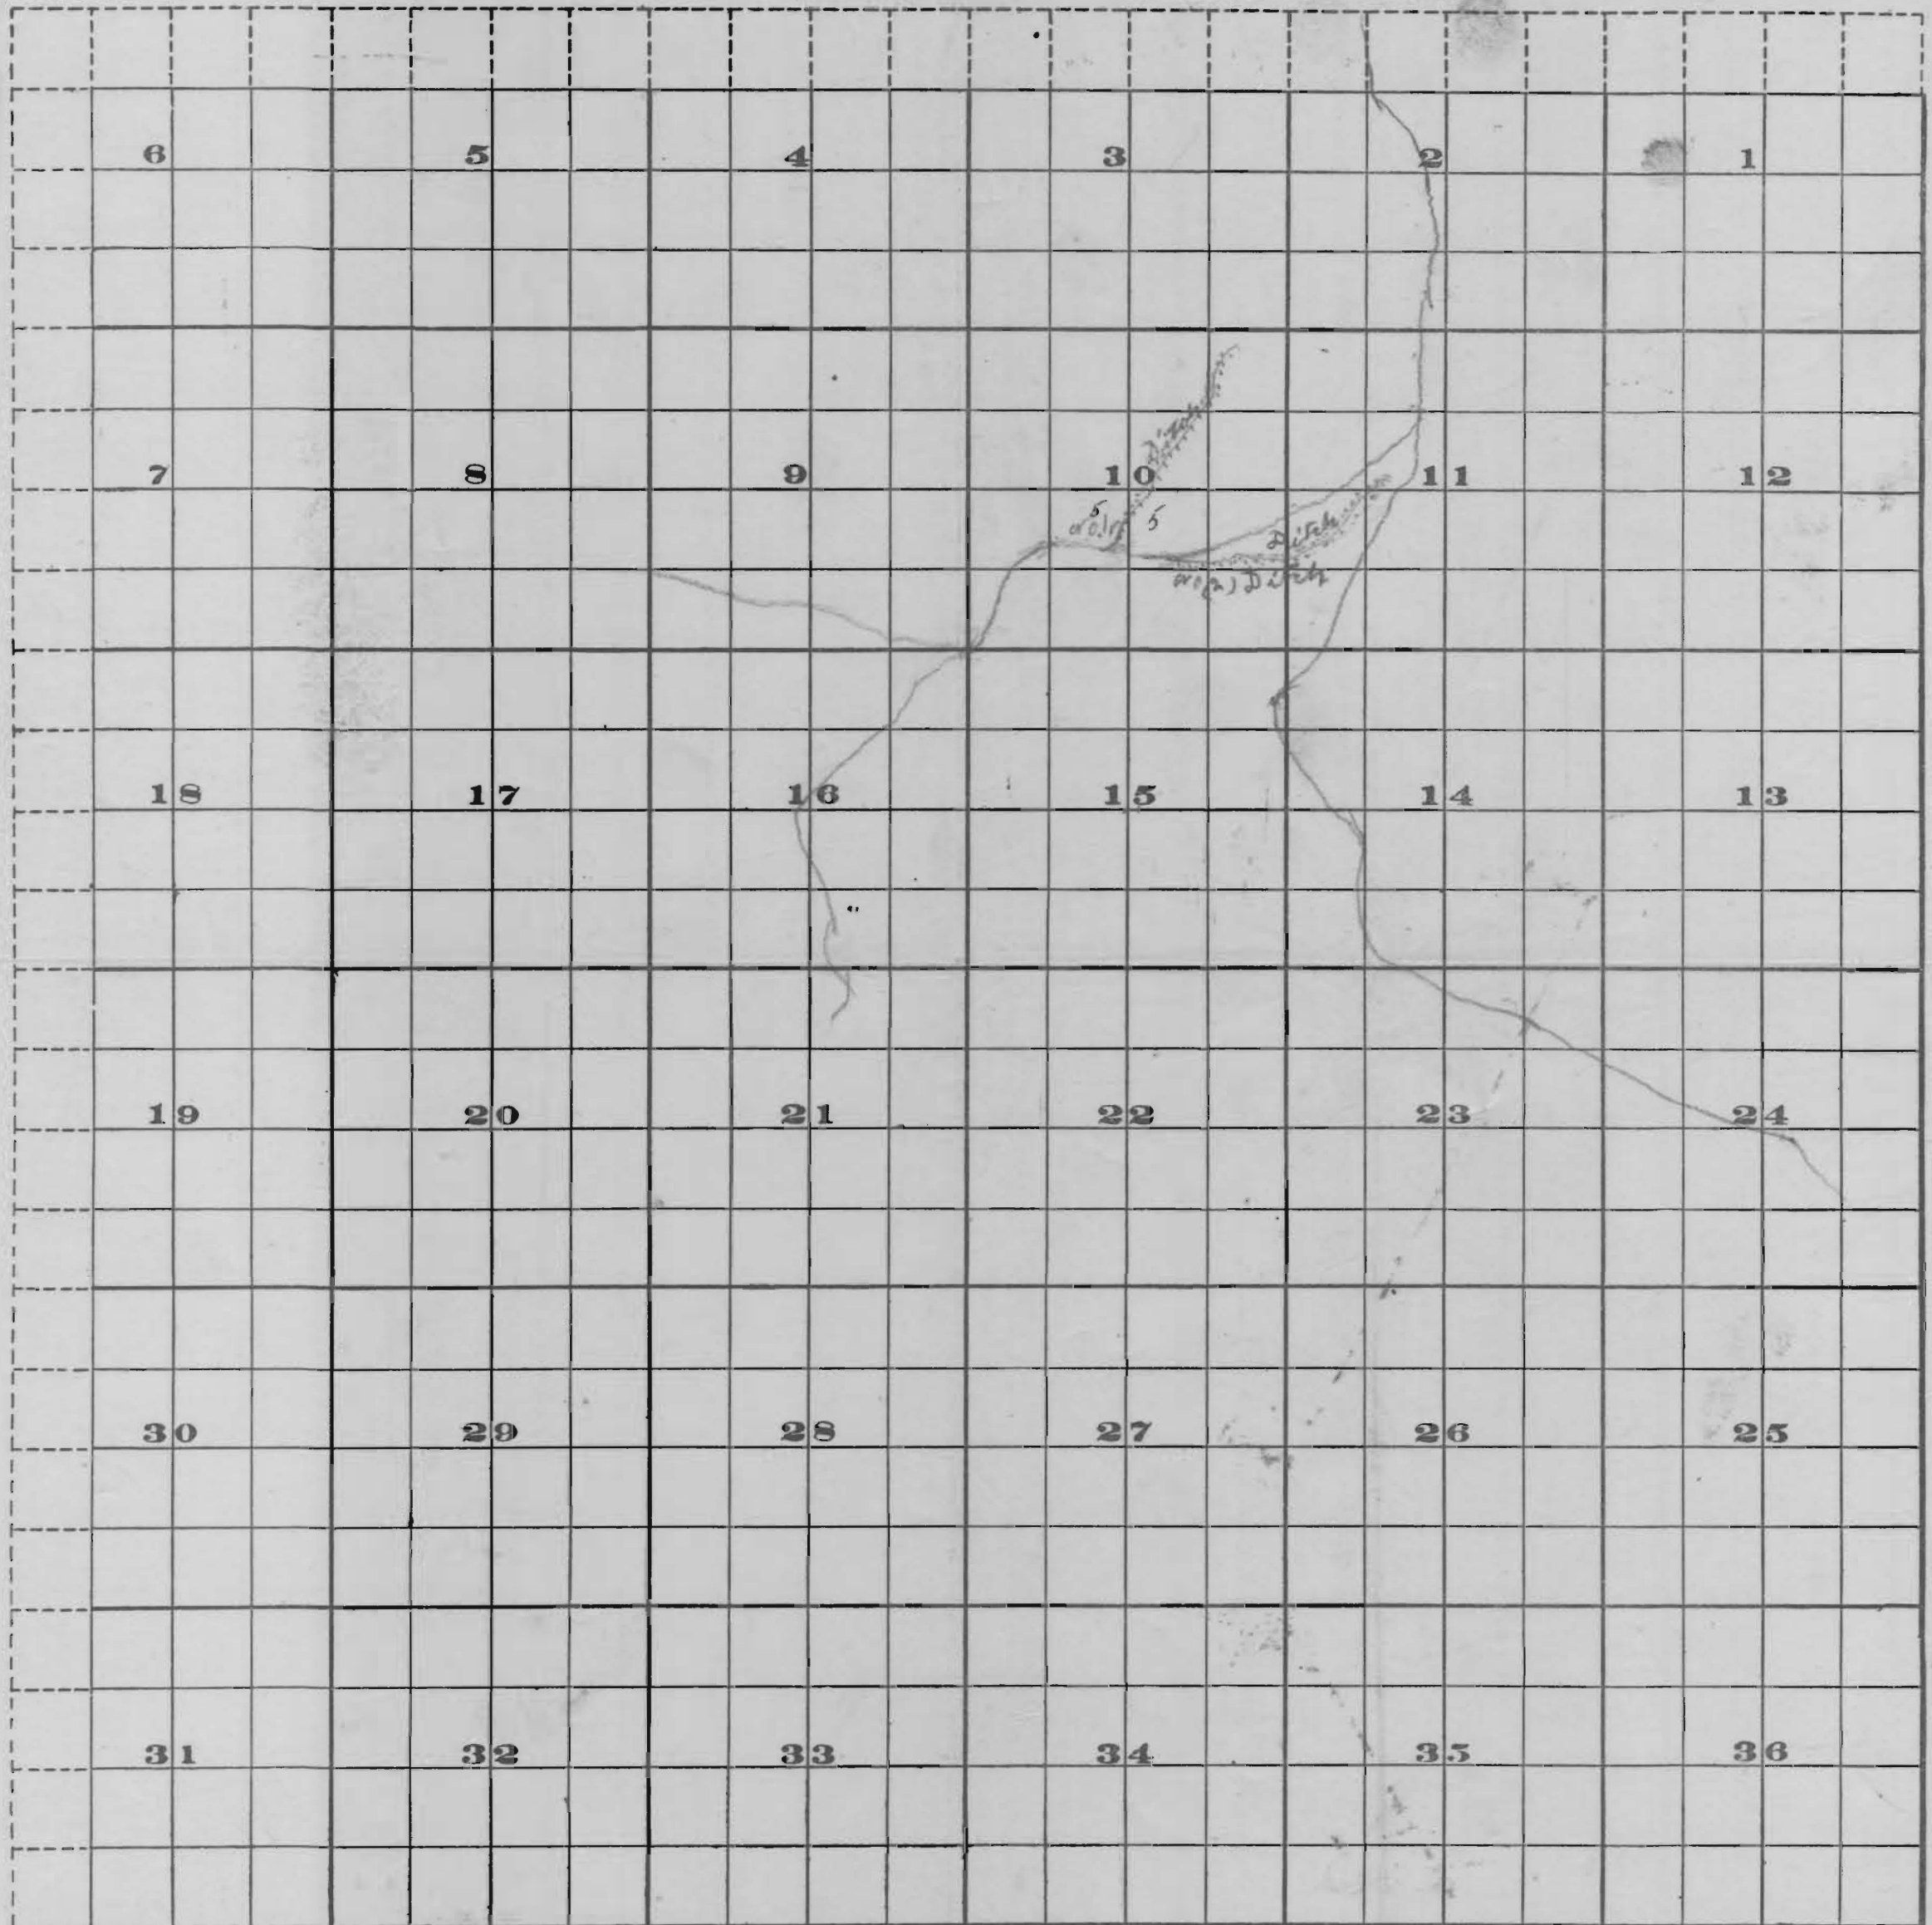

Scale of Feet.