


Sec. 8

Tp. 38 S

R. 4 W

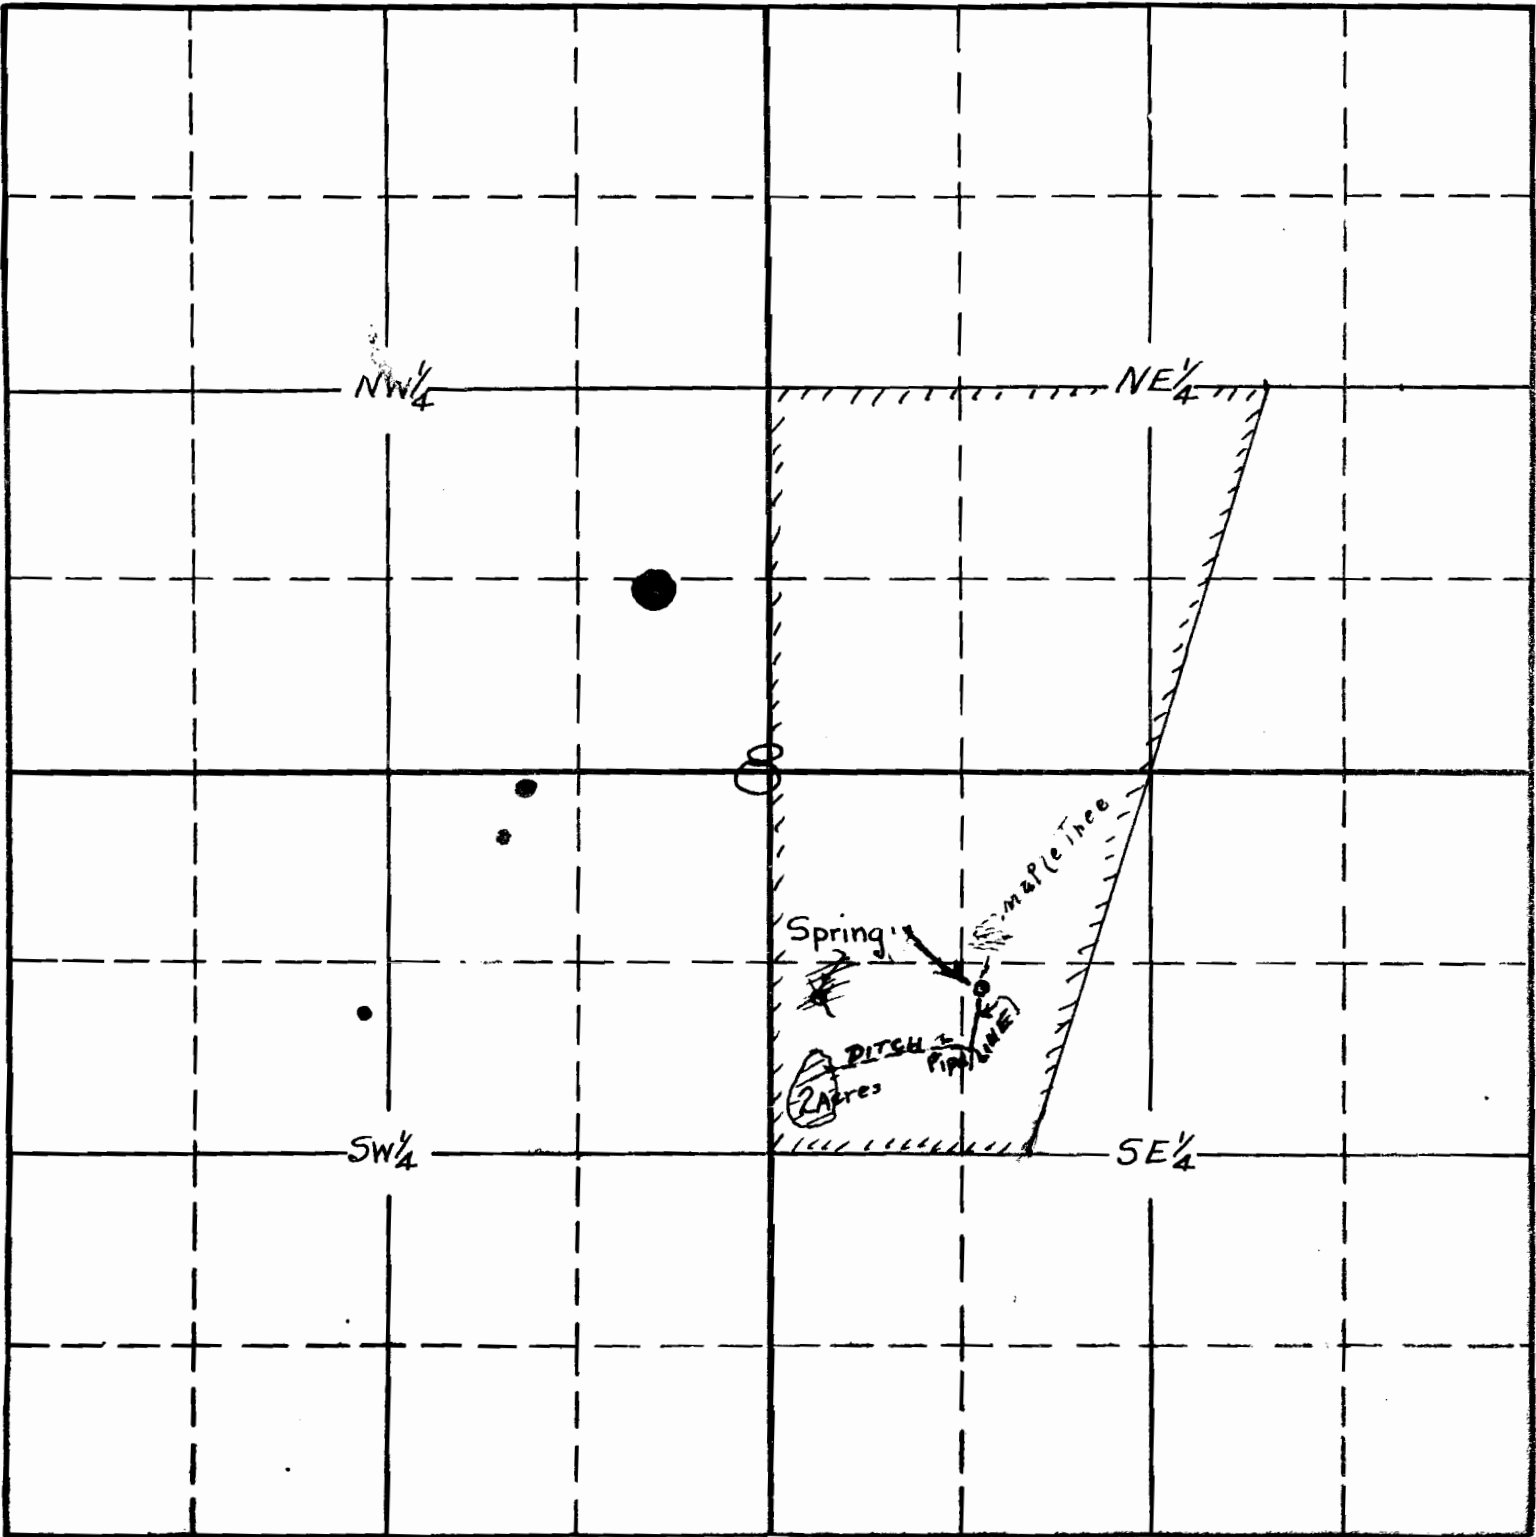

Application No. 12761
Permit No. 9138