


Sec. 30

Tr. 25

R. 7E

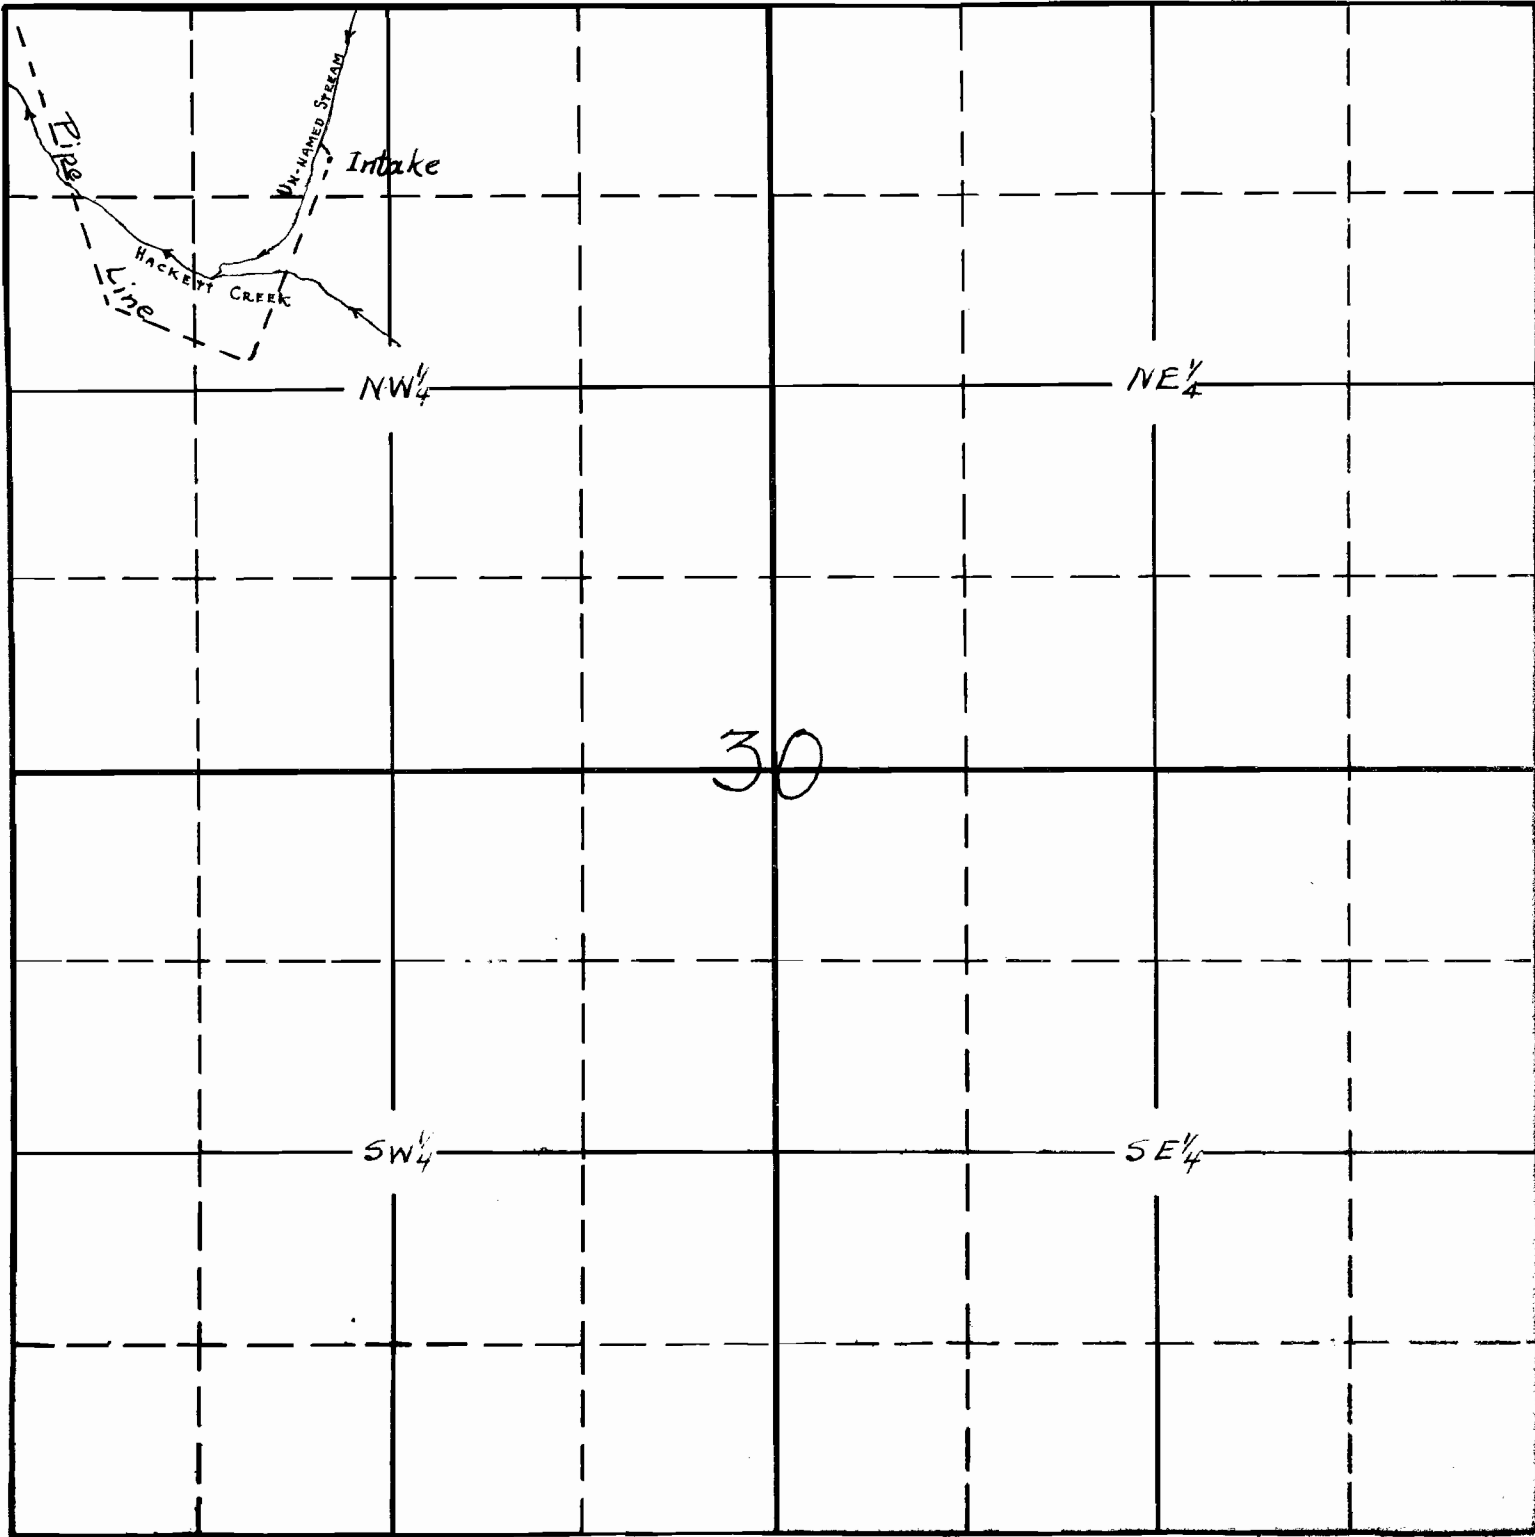

Application No. 12774
Permit No. 9139