


Application No. 12824

Permit No. 9152

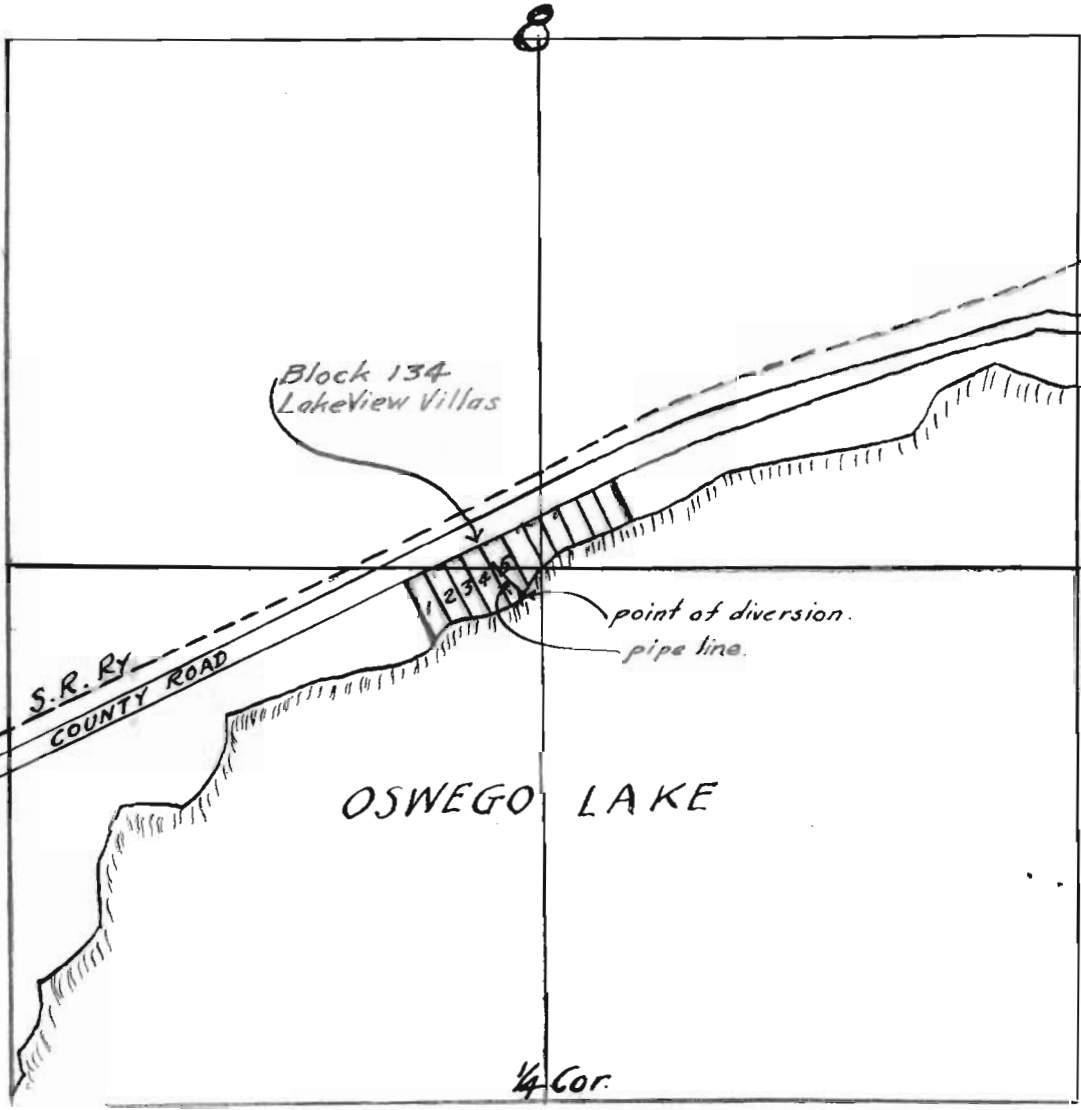

Water is taken from lake at a point 6 ft west of East line of lot 5 Block 134. Used to irrigate lots 4 and 5 and E half lot 3.