

NORTH


Sec. 9
10
15
16

Tp. 6 S
R. 5 W

Application No. 12830
Permit No. 9154

WEST

EAST

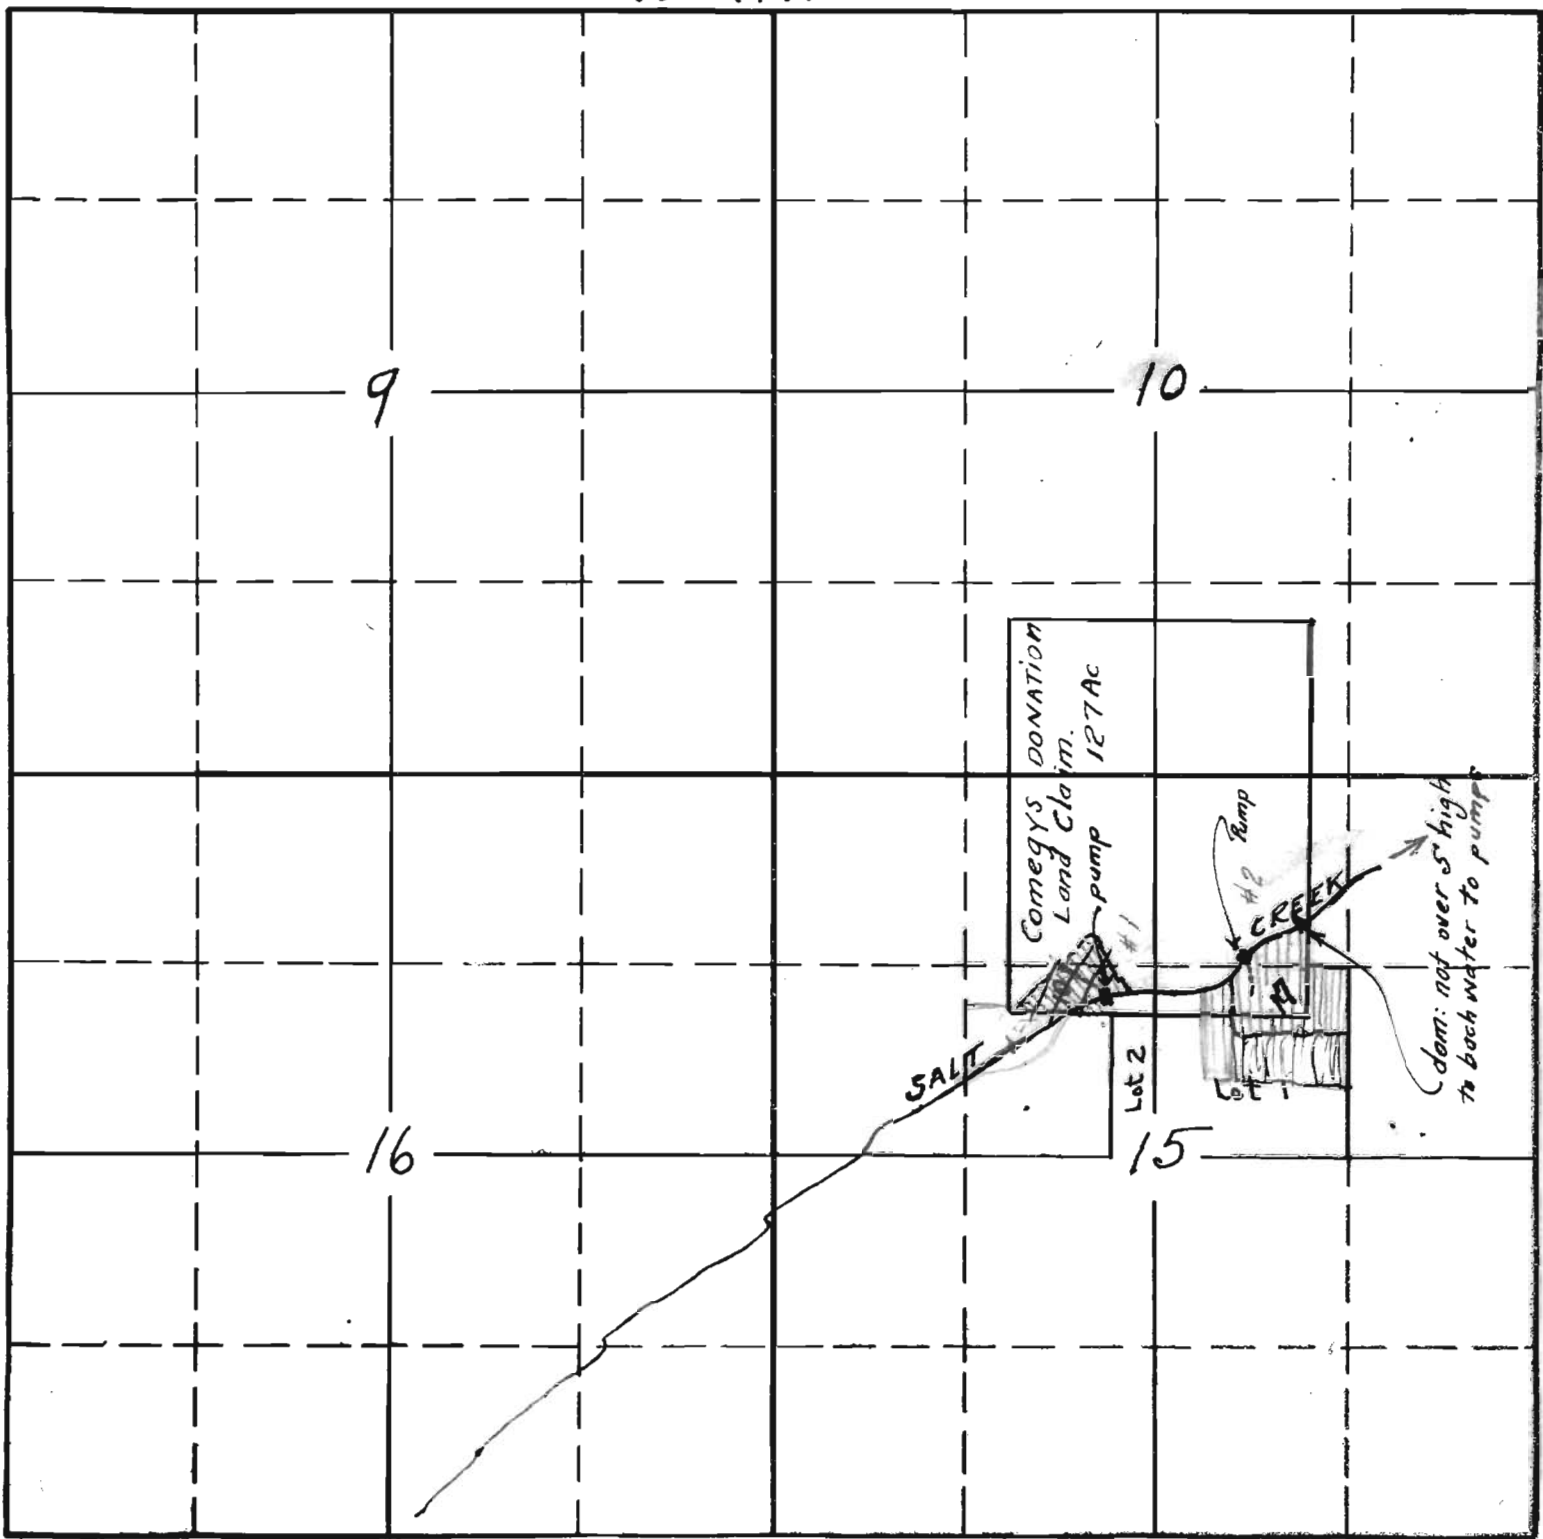

SOUTH