


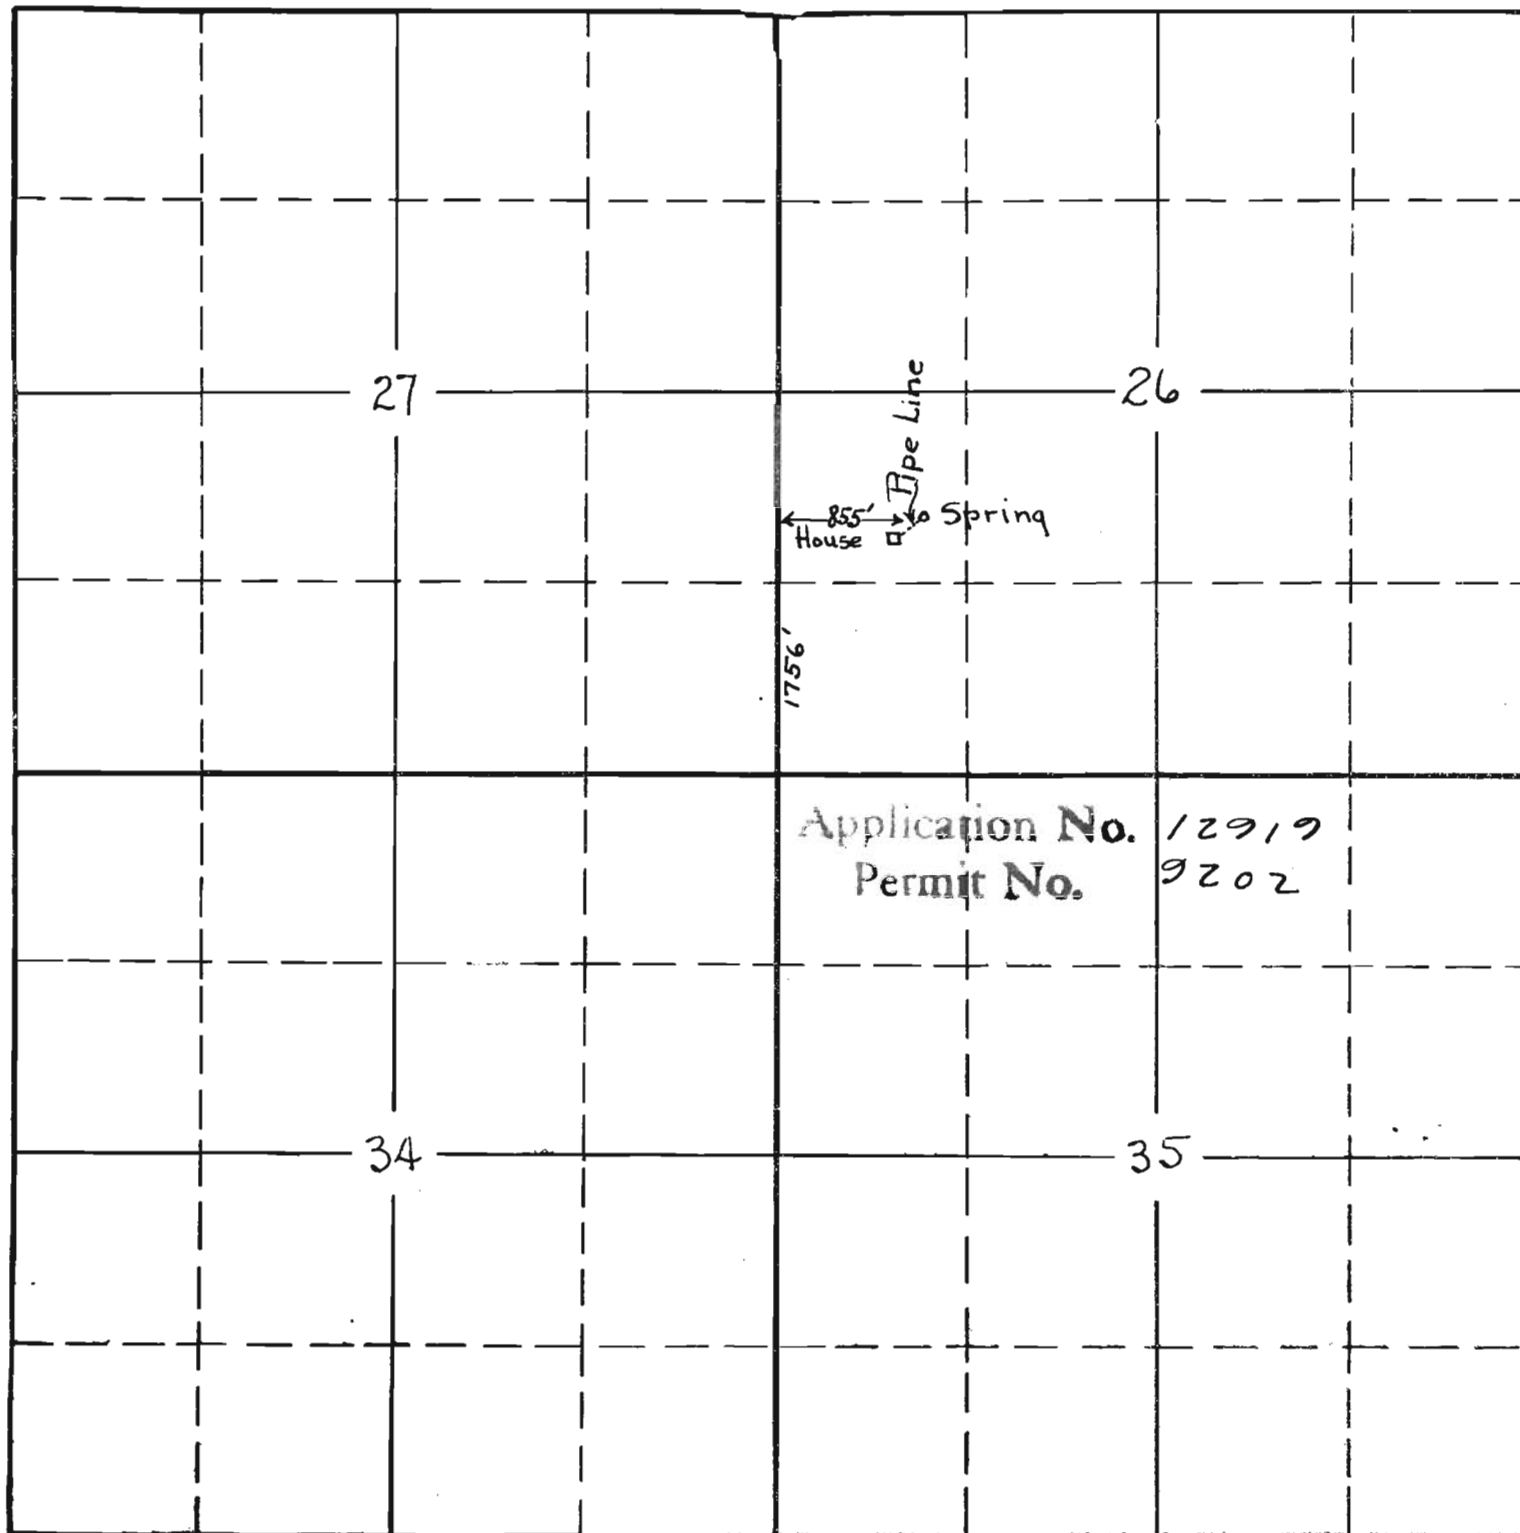

Sec. _____

Tp. 14 S

R. 12 W

Application No. 12919
Permit No. 9202