


TWP 15. R 44 E. W. M.

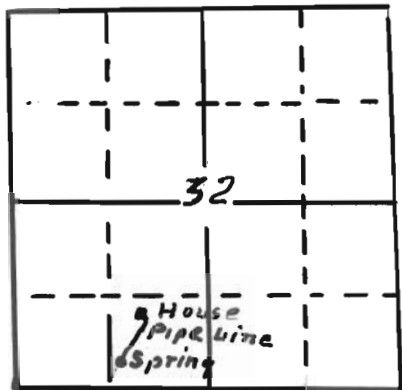

Application No. 12982

Permit No. 9205