


RECEIVED

OCT 7 1980

WATER RESOURCES DEPT.
SALEM, OREGON

R.O.D.
90' N. & 296'
W. FROM THE
W.E. COR. OF
ISAAC LEMASTERS
D.L.C.
BEING WITHIN
SW 1/4 NW 1/4 NW 1/4
OF SEC. 1

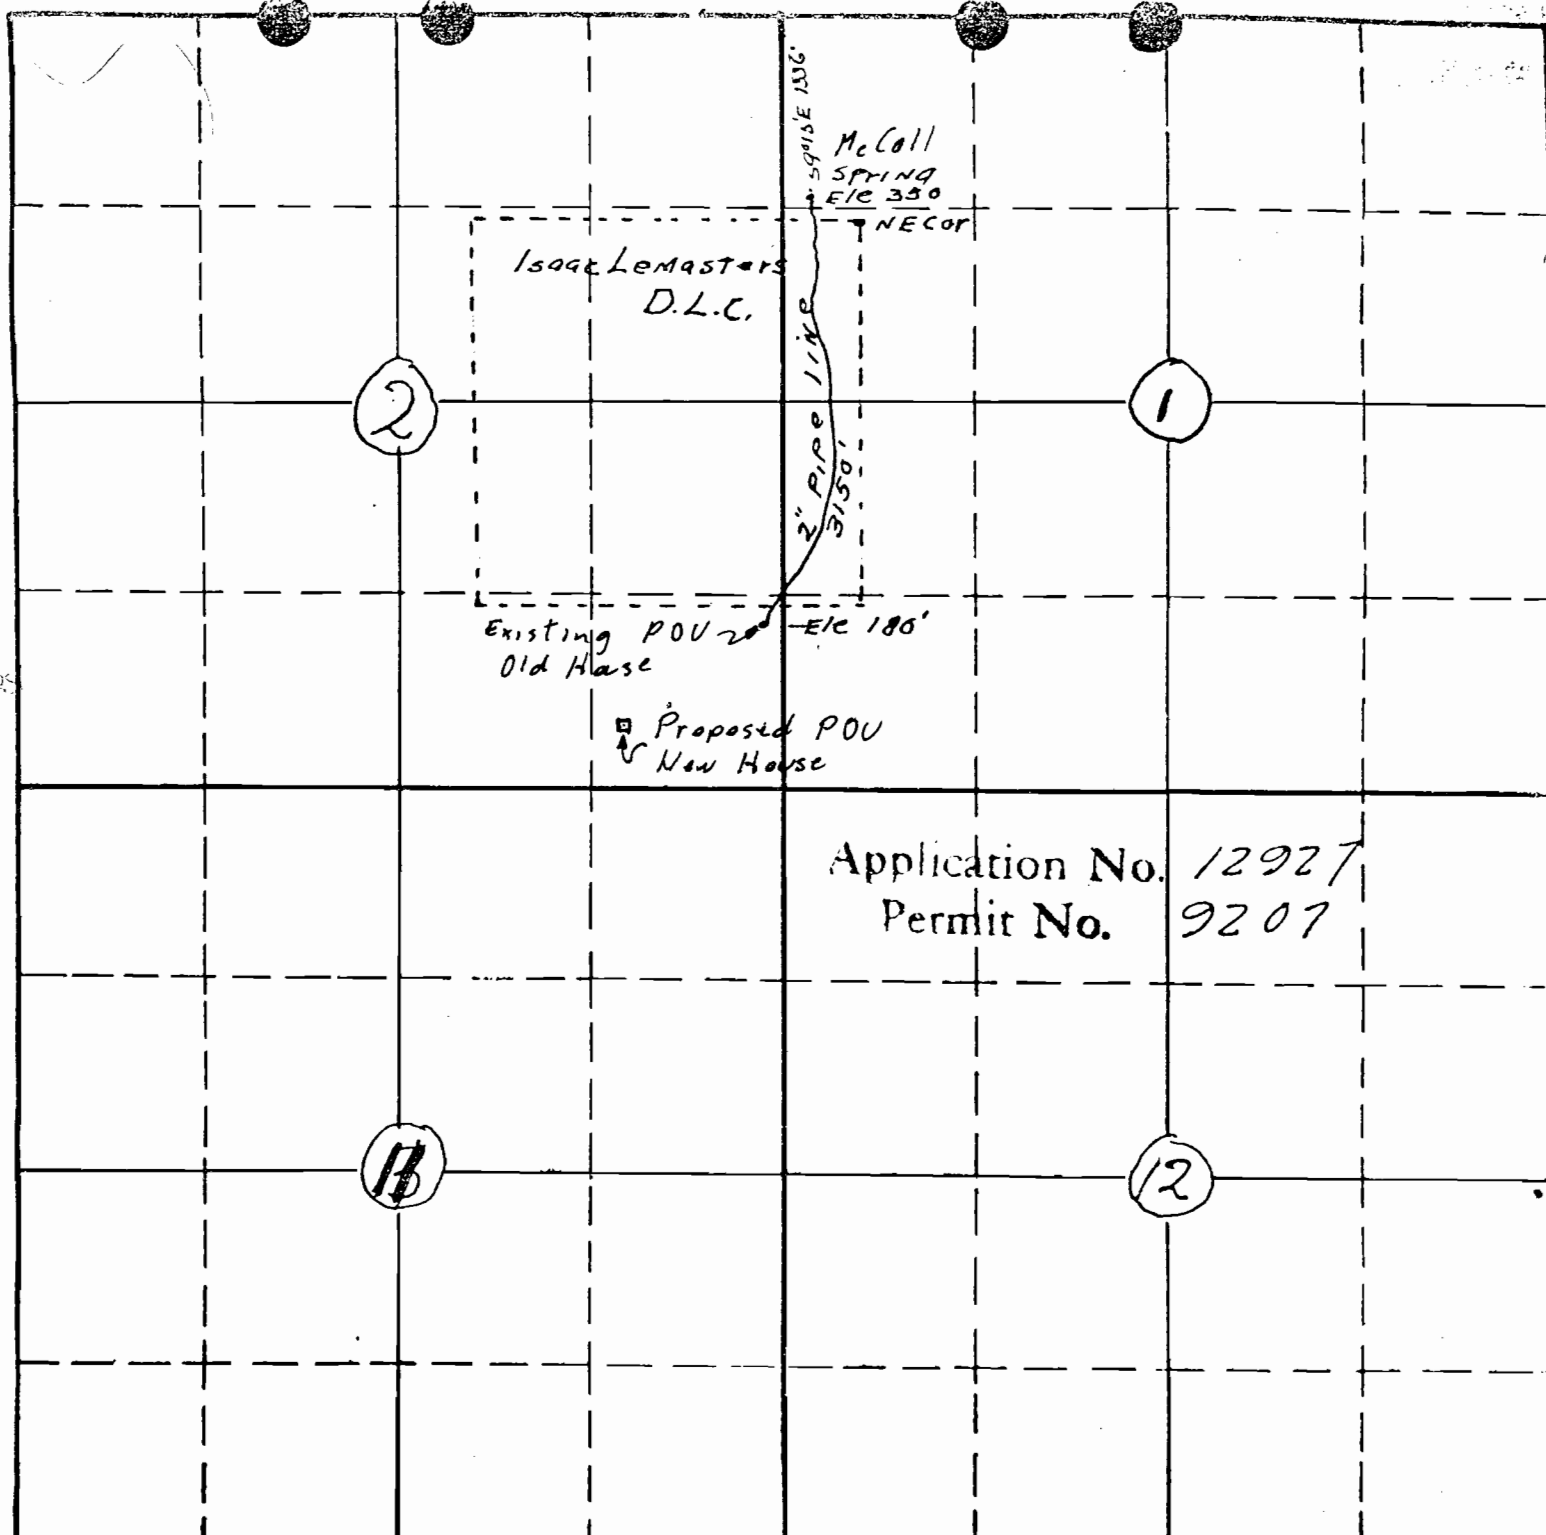

Sec. 1

Tp. 4

R. P 5 W

Application No. 12927
Permit No. 9207

1076