


Application No. 12740

Permit No. 9250

27

26

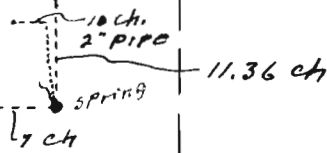

34

35

R. 11 W

Tp. 7 S

Sec. 35