


Sec. 23

Tp. 15.

R. 4W.

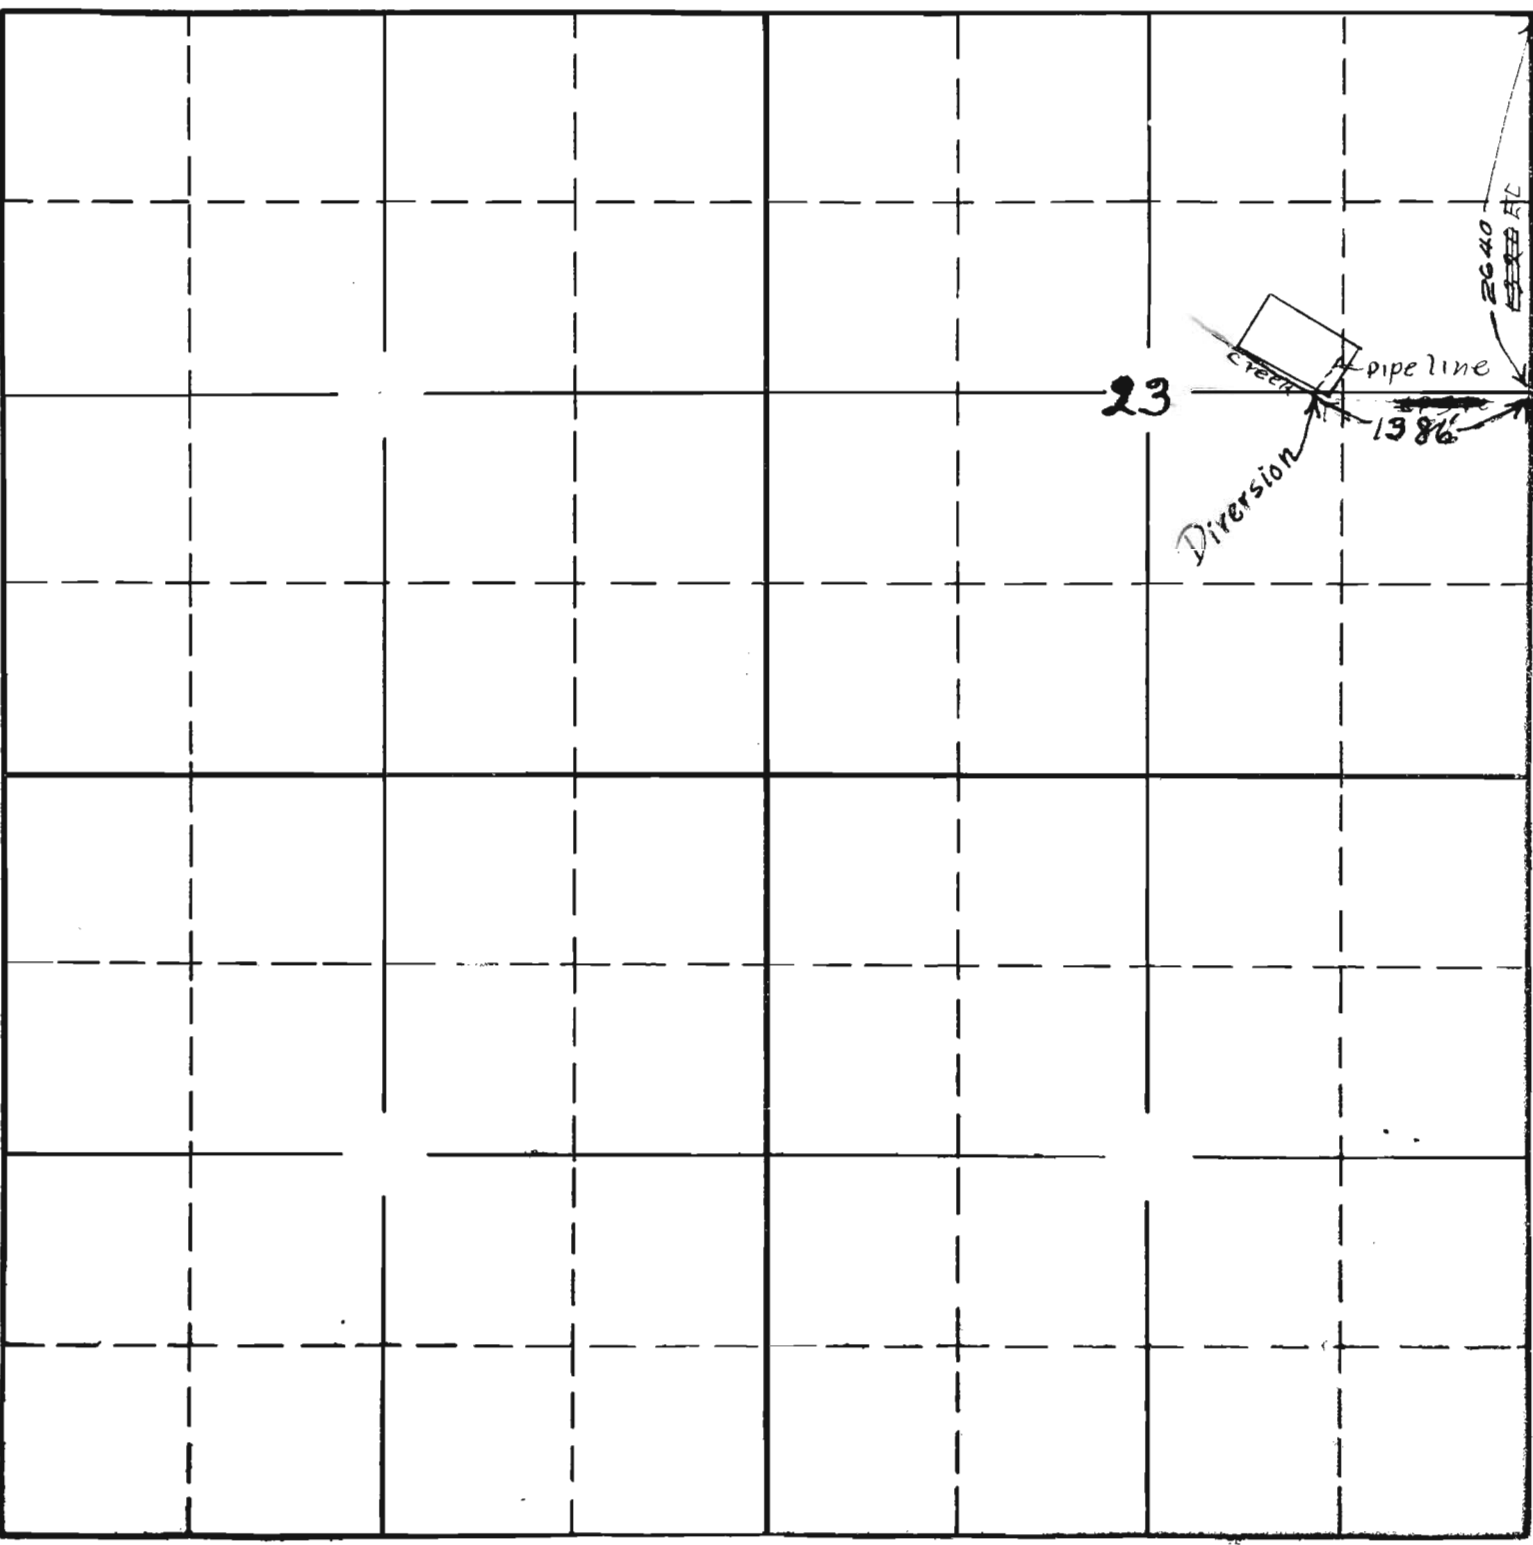

Application No. 12891
Permit No. 9258