


Application No. 13007
Permit No. 9285

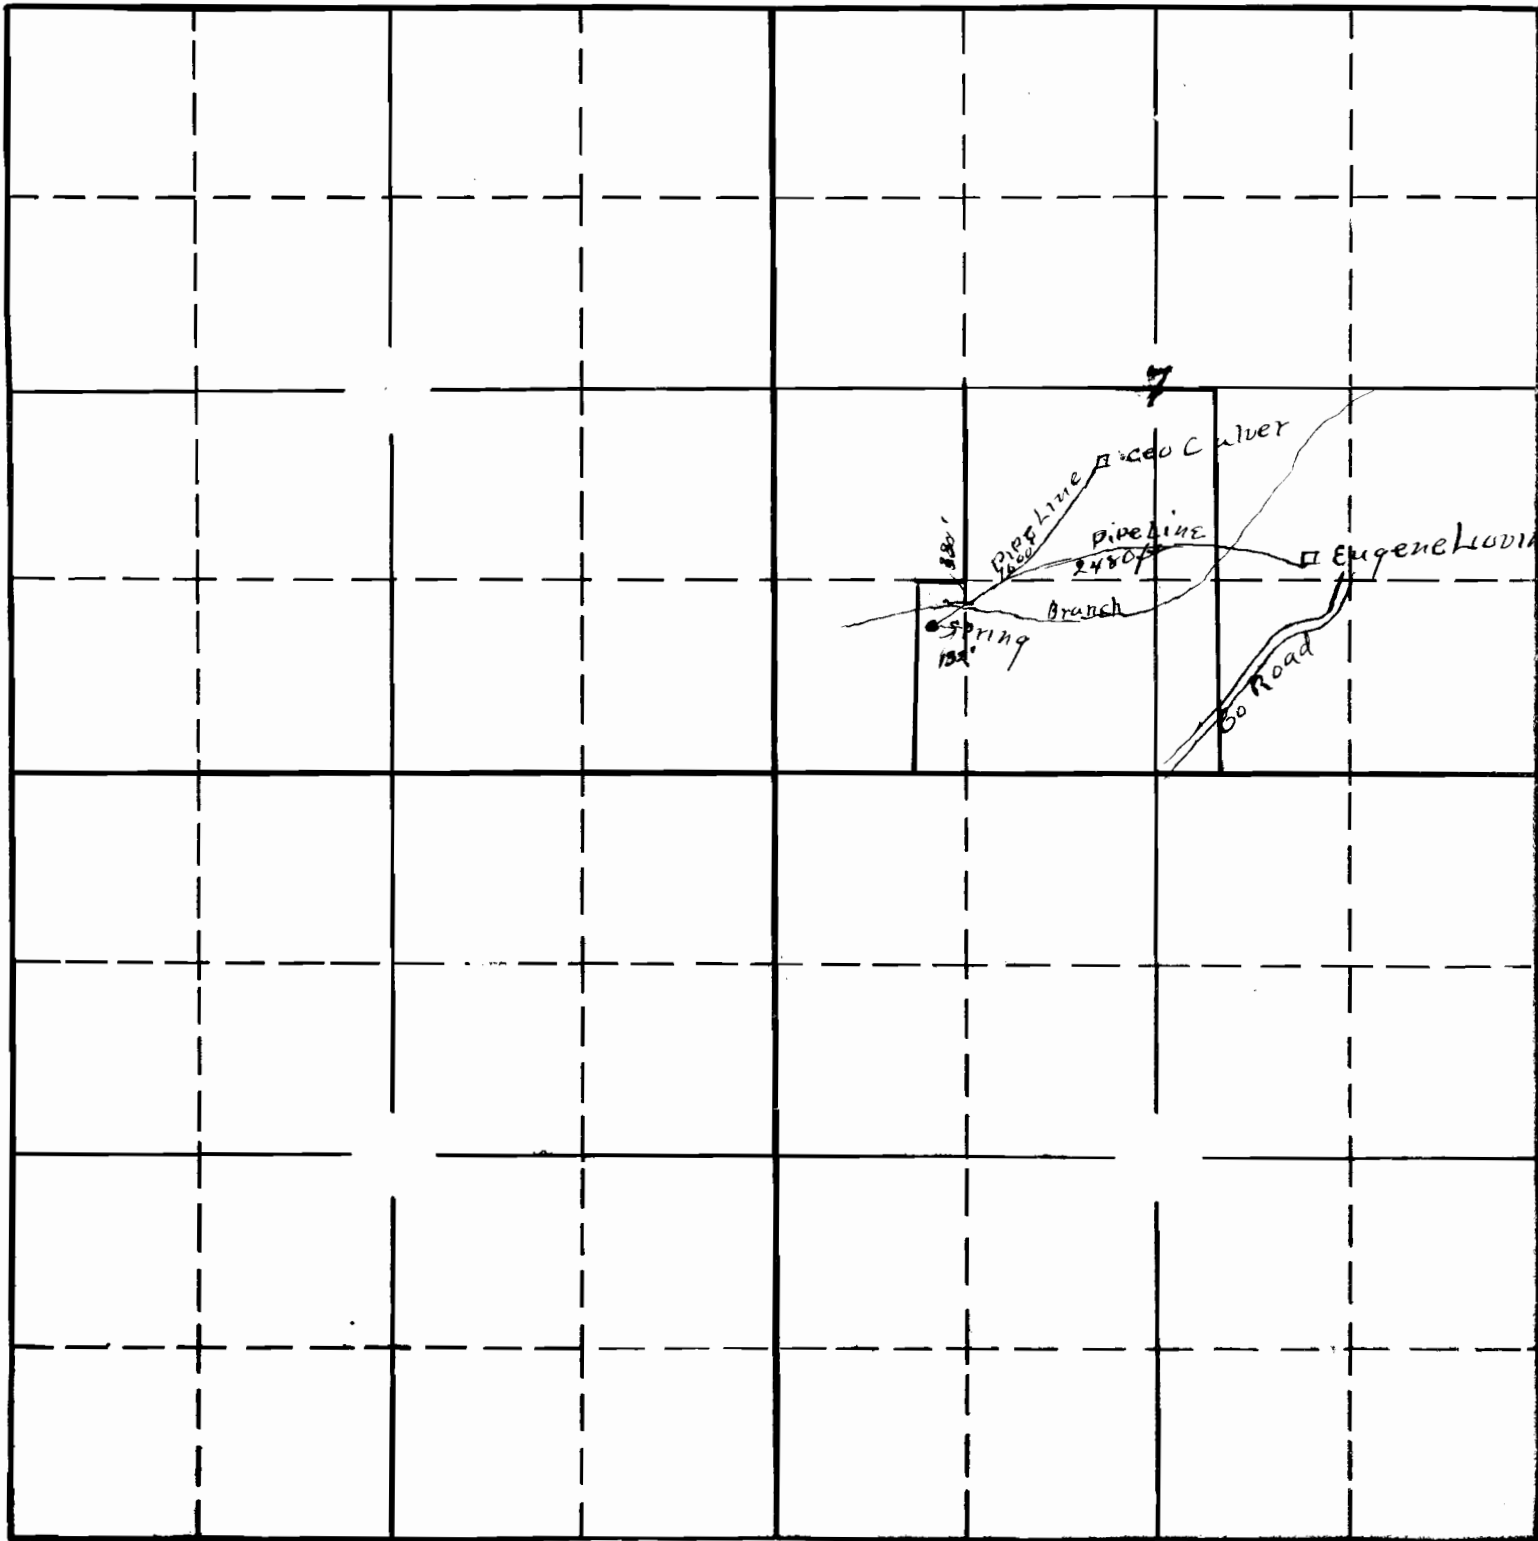

Sec. 7

Tp. 12

R. 4W.