


Sec. /

Tp. /

R. /

O = source  
→ at intersection  
is point of  
diversion

cut to be irrigated  
1A.

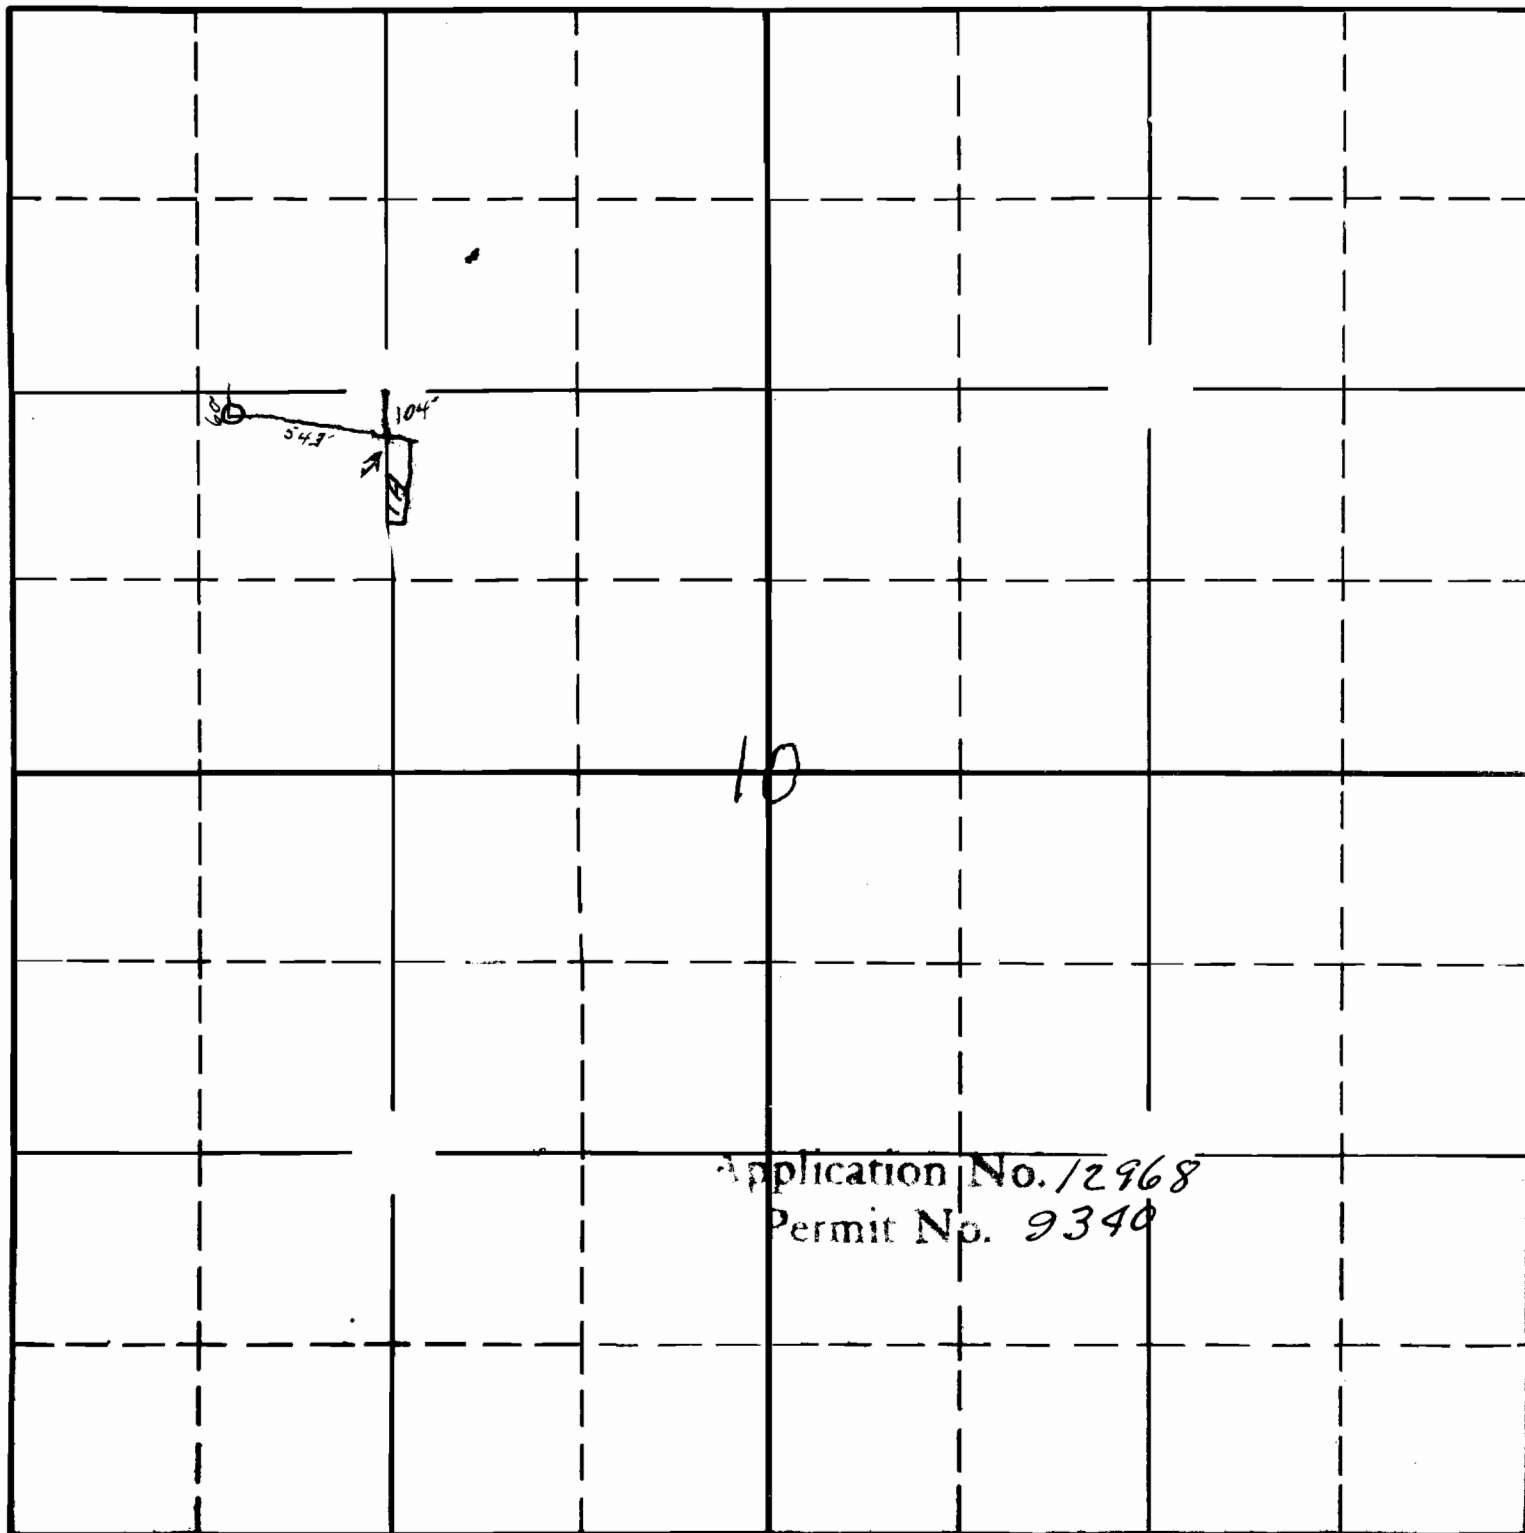

Application No. 12968

Permit No. 9340