


SEC 27 Tp. 19 S. R. 12 W. Will Mer.

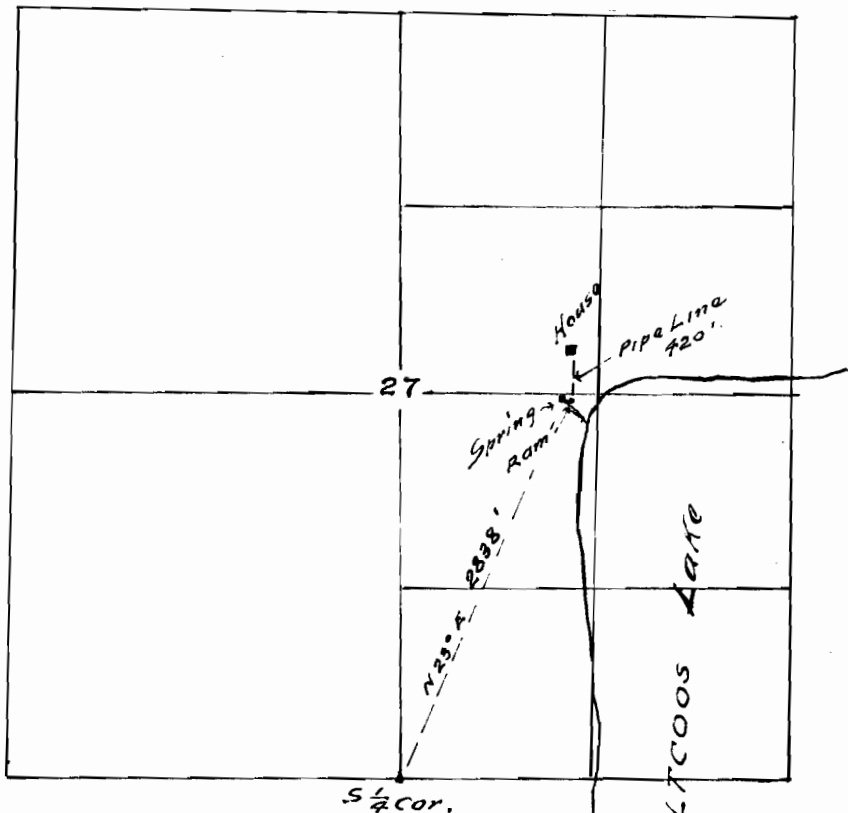

Scale 1 Mile = 4"

13108  
9361