


SECTION

TOWNSHIP 55, RANGE 5W, W. M.

North

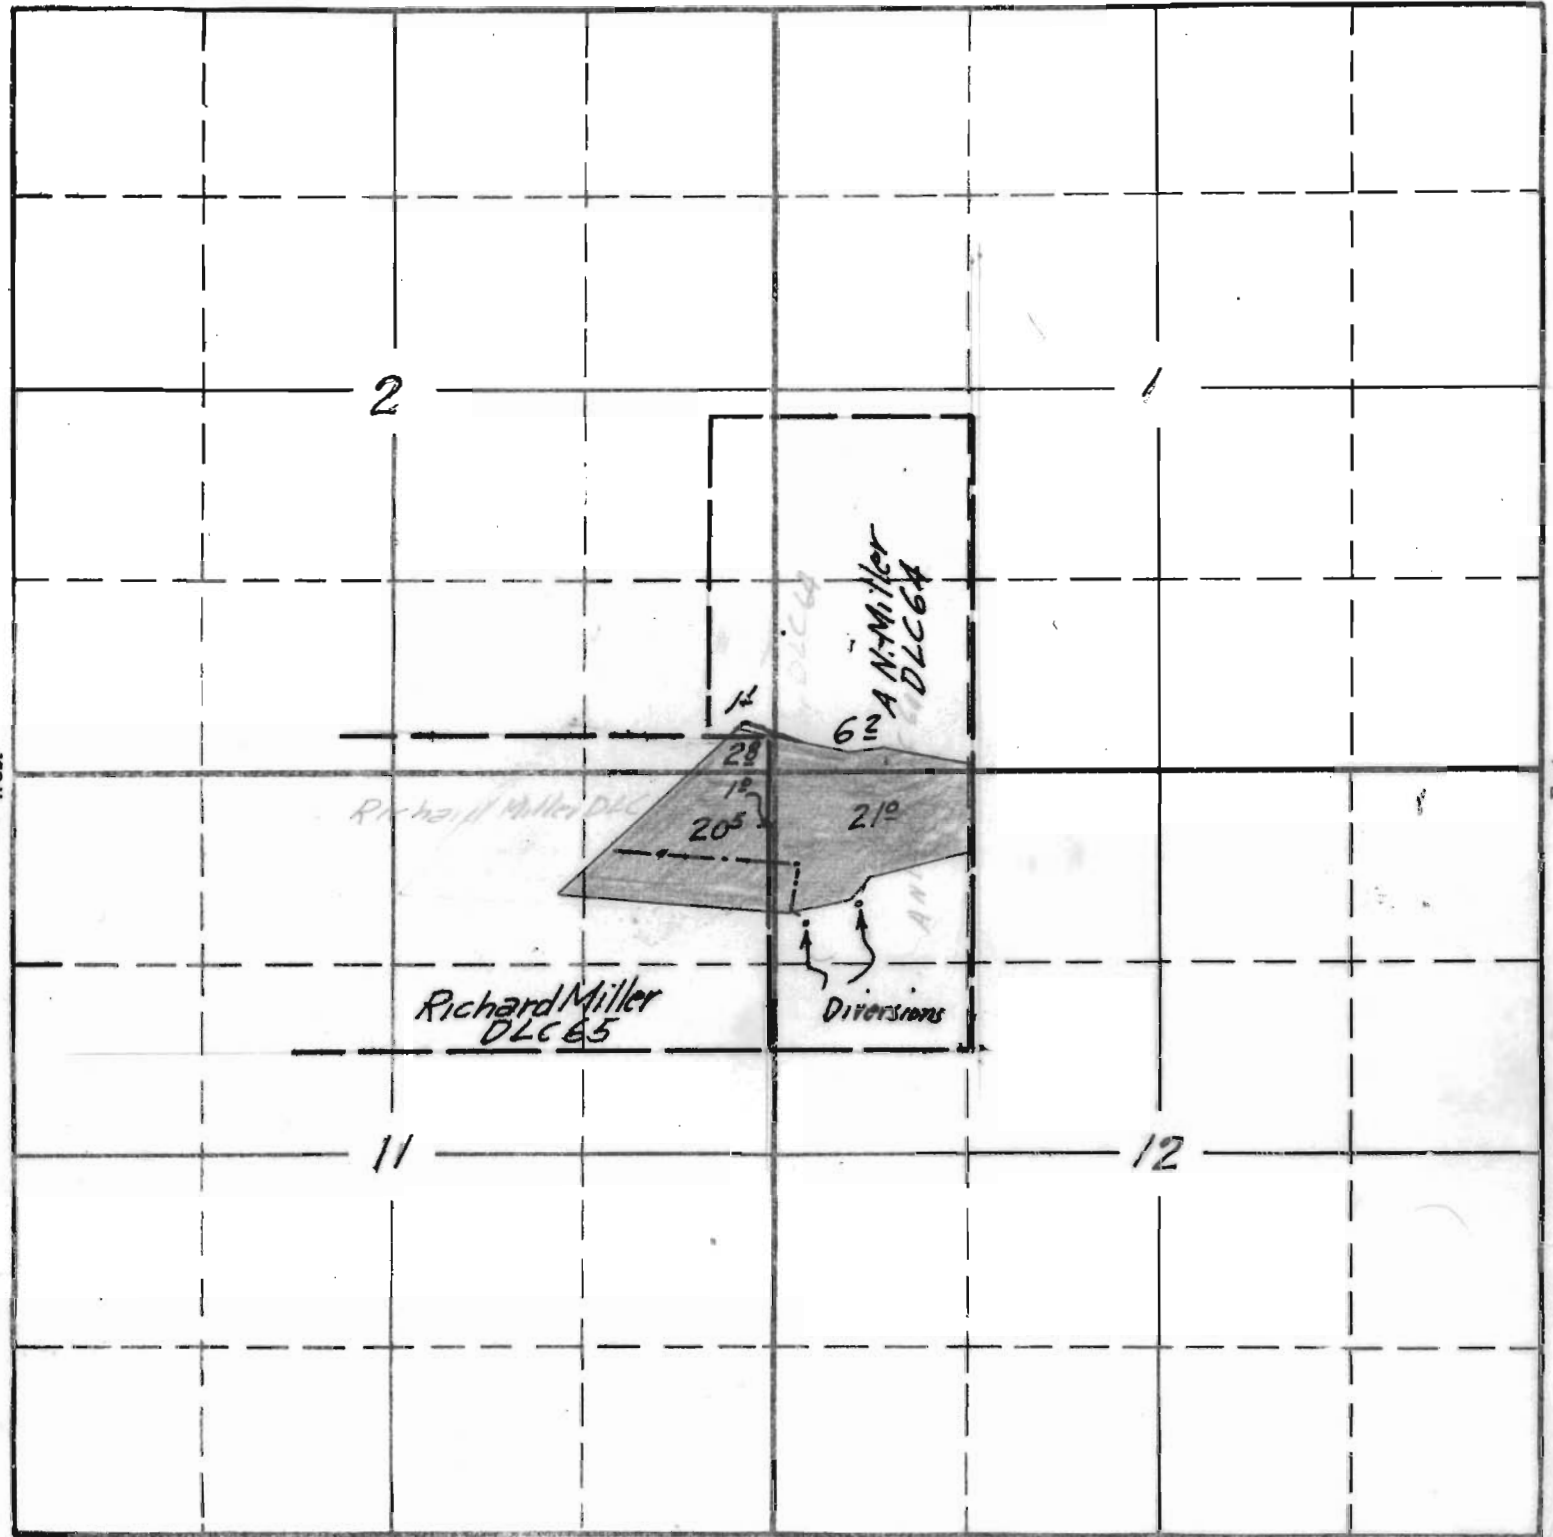

West

East

Surveyed June 4 1940 RAB

South


APPLICATION No. 13170
PERMIT No. 9400

Sec. 12
NW 1/4
E 1/2 NW 1/4

Tp. 55
R. 5W

1 East
792' South

30

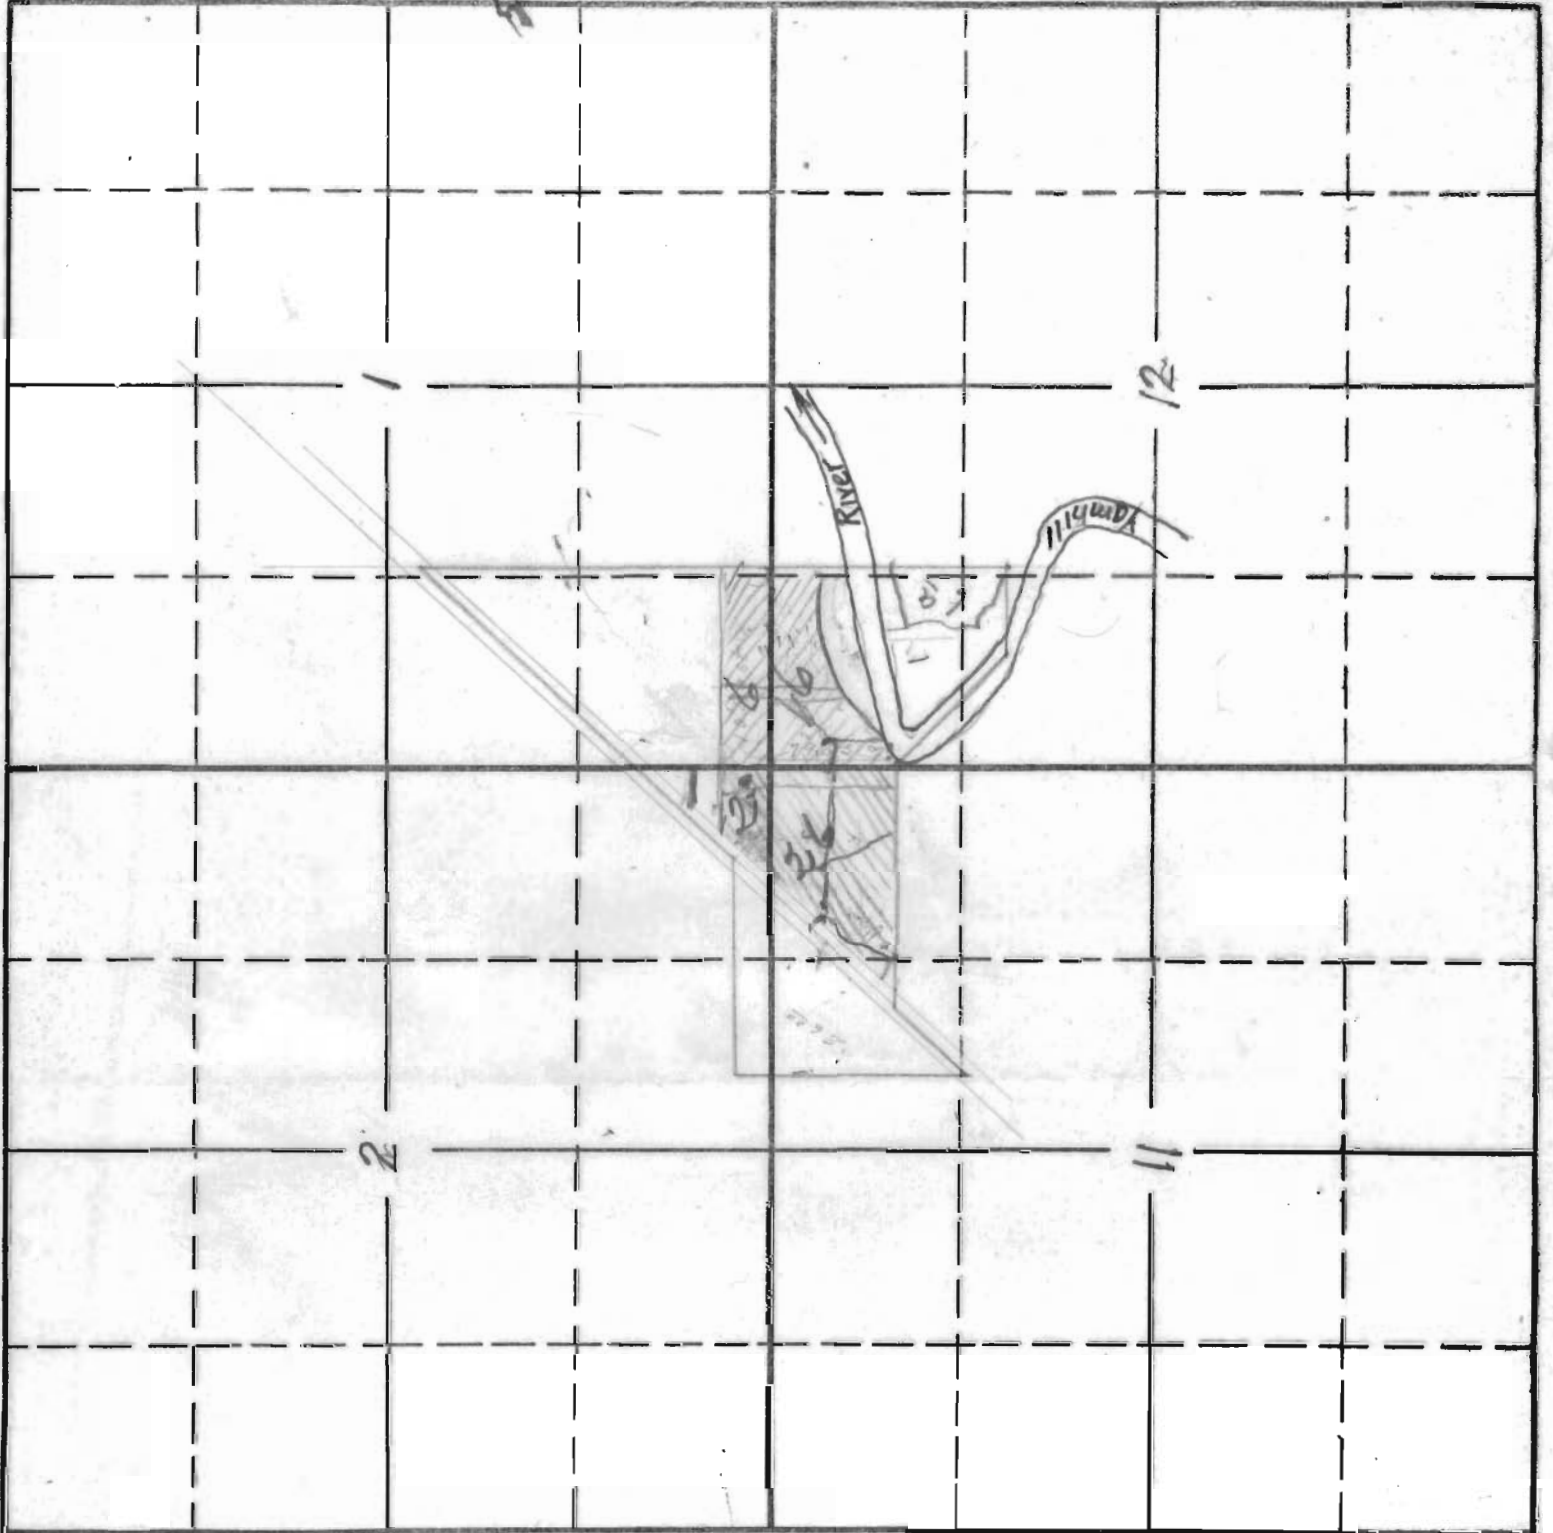

Application No. 13170
Permit No. 9411