

Sec. 1

Tp. 29S

R. 8W

1

D.L.C. #45

UPPER TEN MILE CREEK

Spring


Lot 6

Lot 7

Lot 8

Lot 9

Application No. 13182
Permit No. 9434

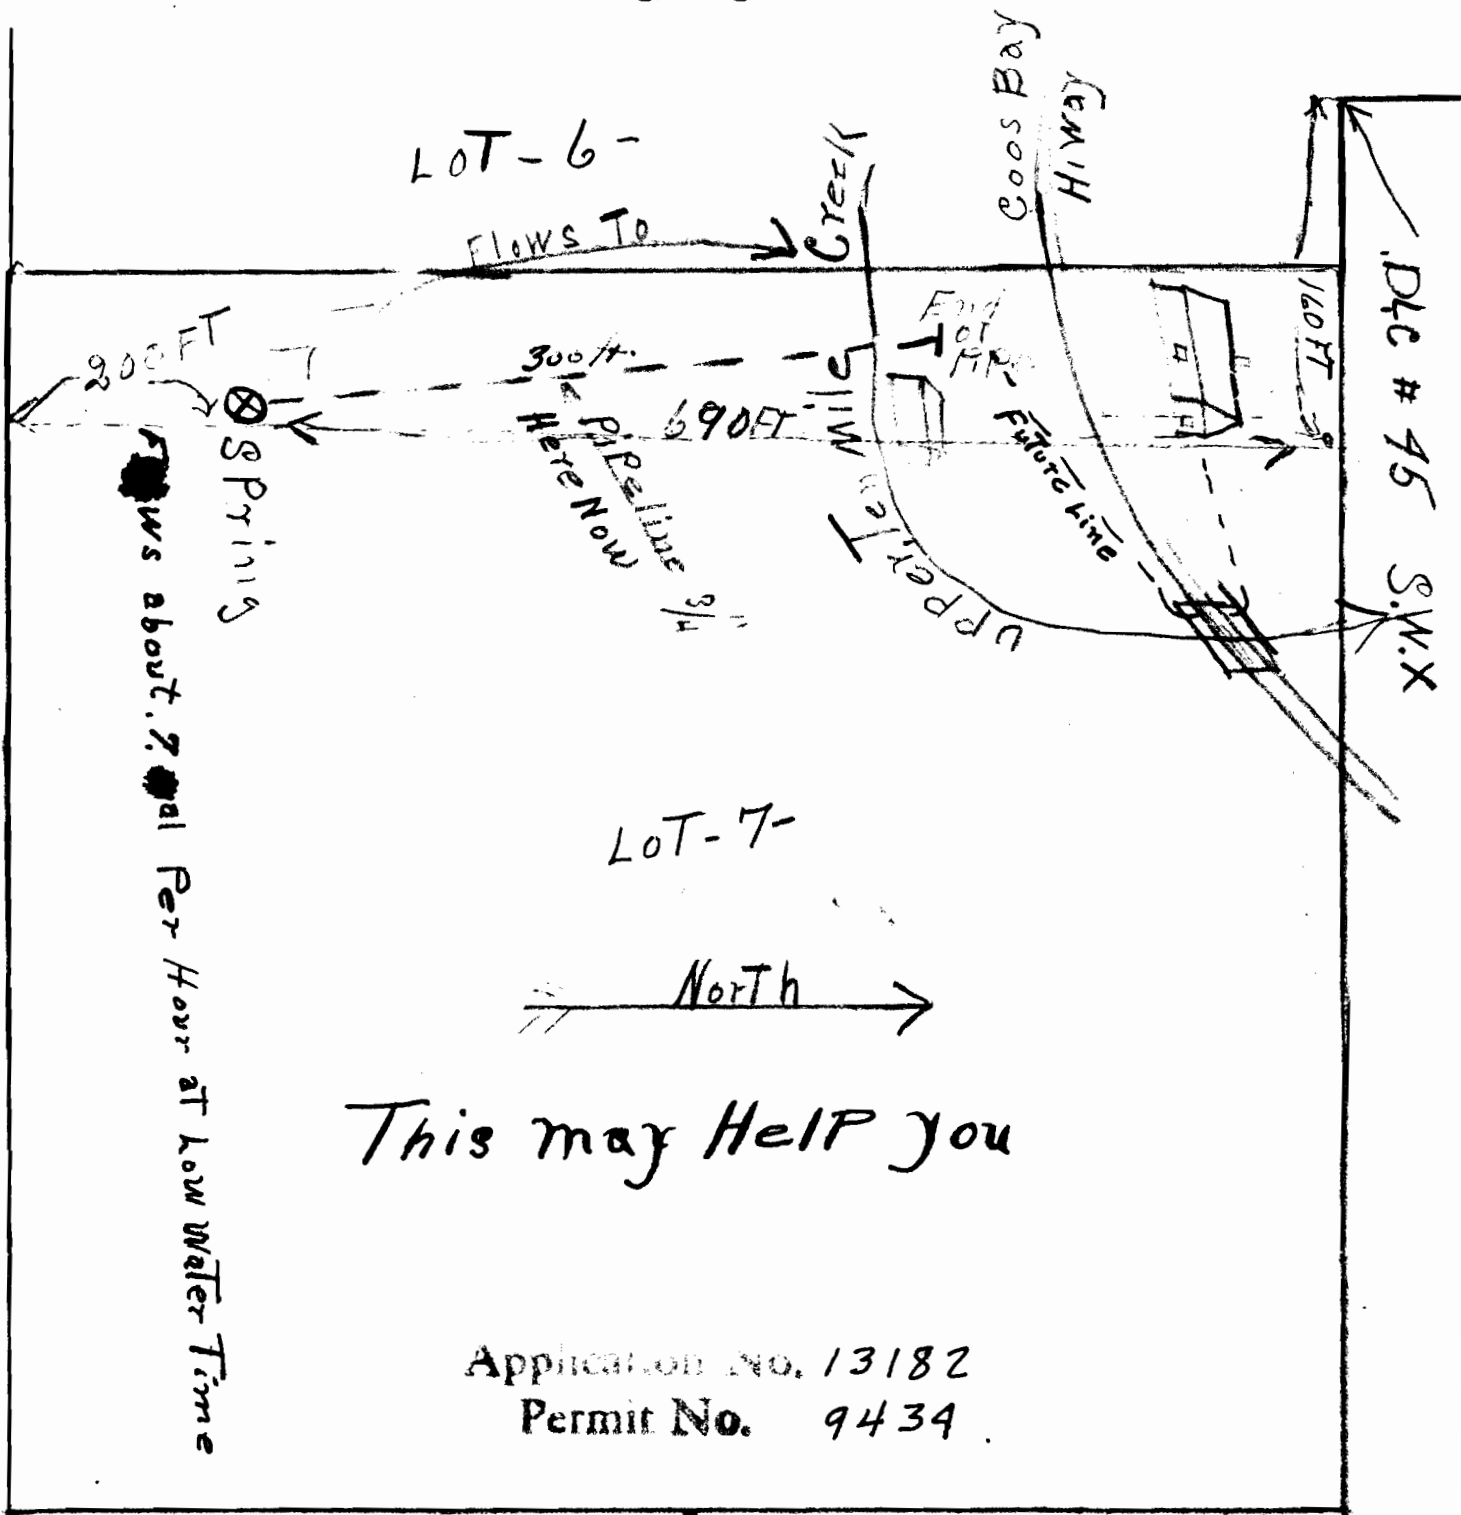

This may HELP you

Application No. 13182

Permit No. 9434

O.K. P. Lot Seal T295R8W