


T285 R6W

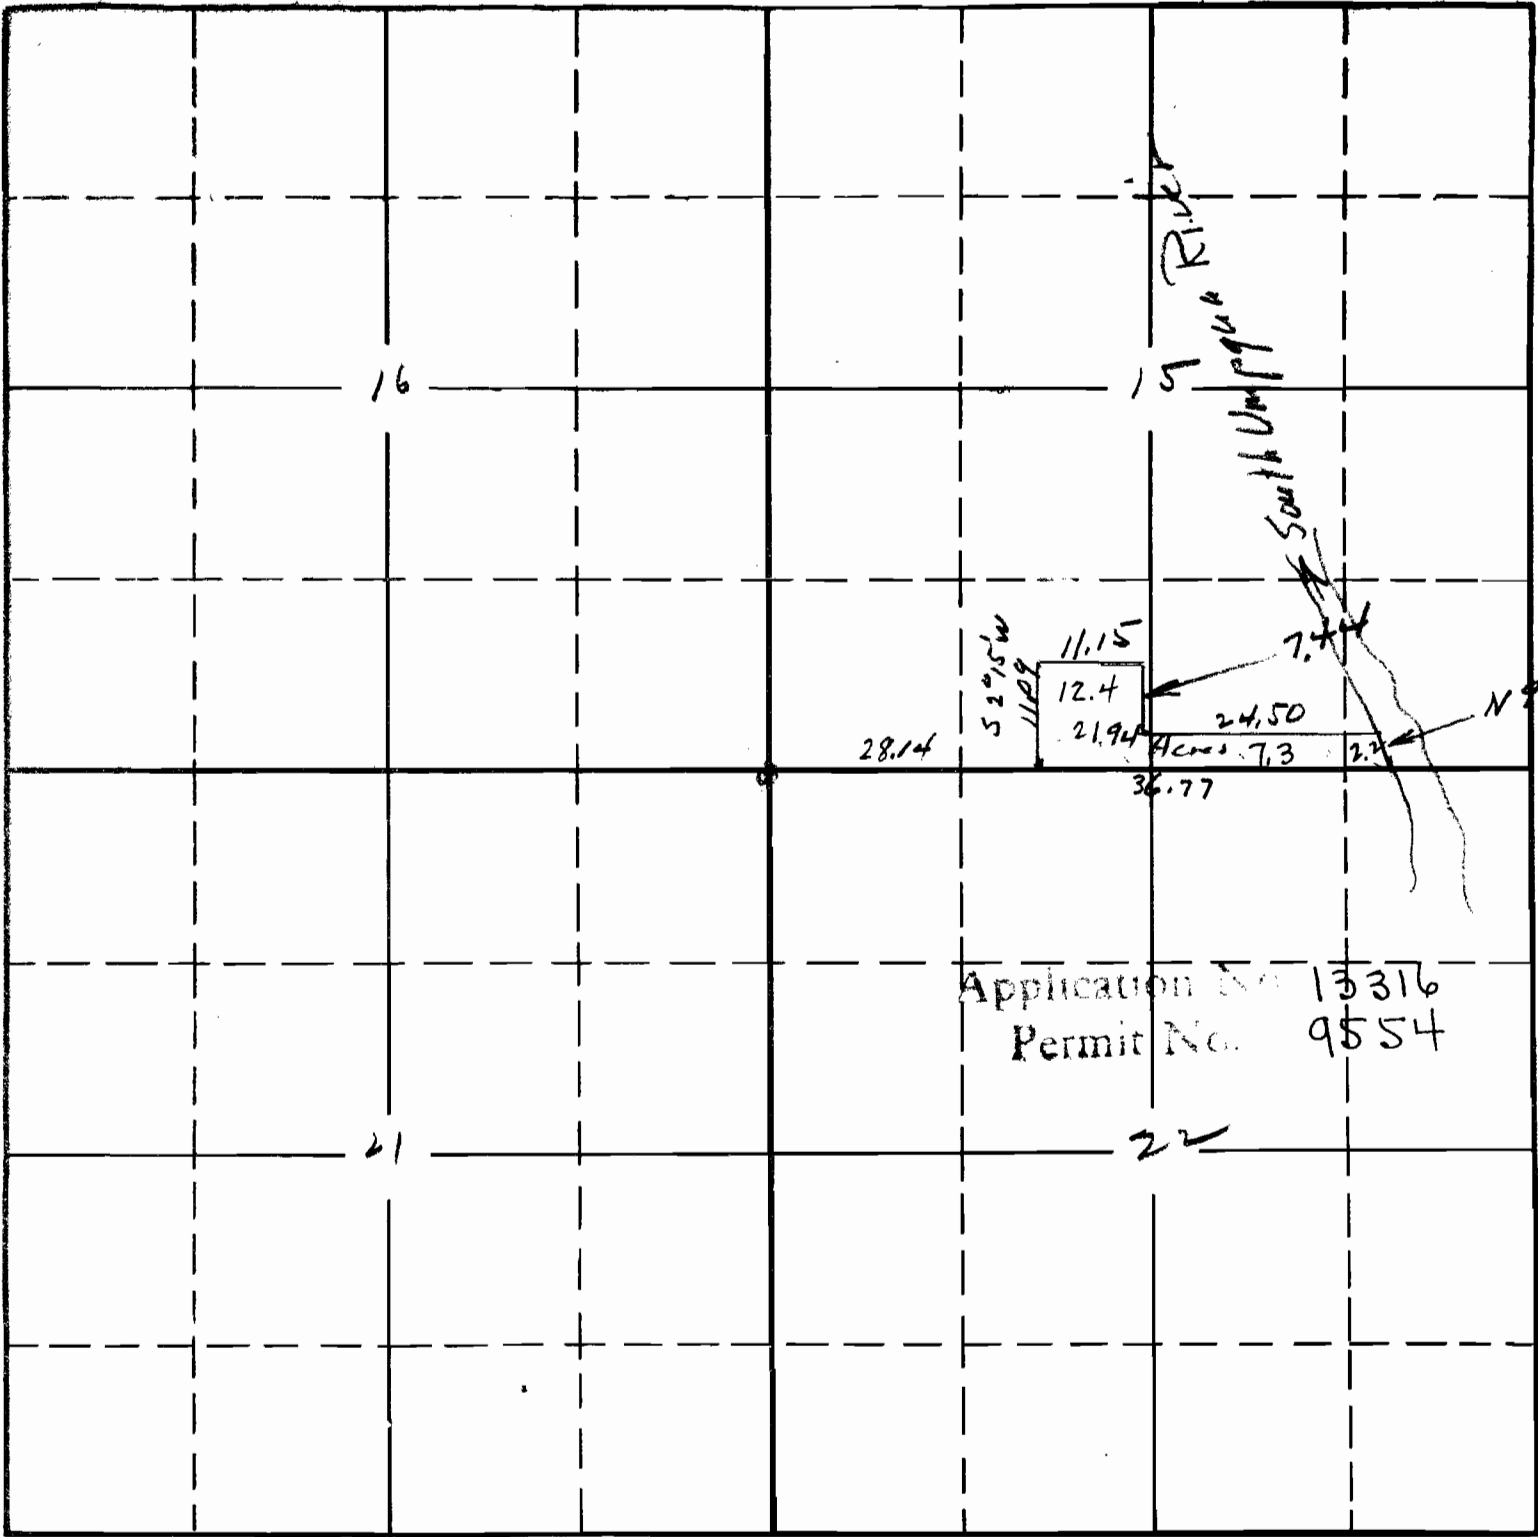

28.14

52° 15' W  
1189

11.15

12.4

21.94

24.50

Acres 7.3

36.77

7.3

2.7

N 9° 38' W 384 chs

Application No 13316

Permit No 9554

16

21

22

R.  
Tp.  
Sec.