


Sec. 4

Tp. 415

R. 13 W

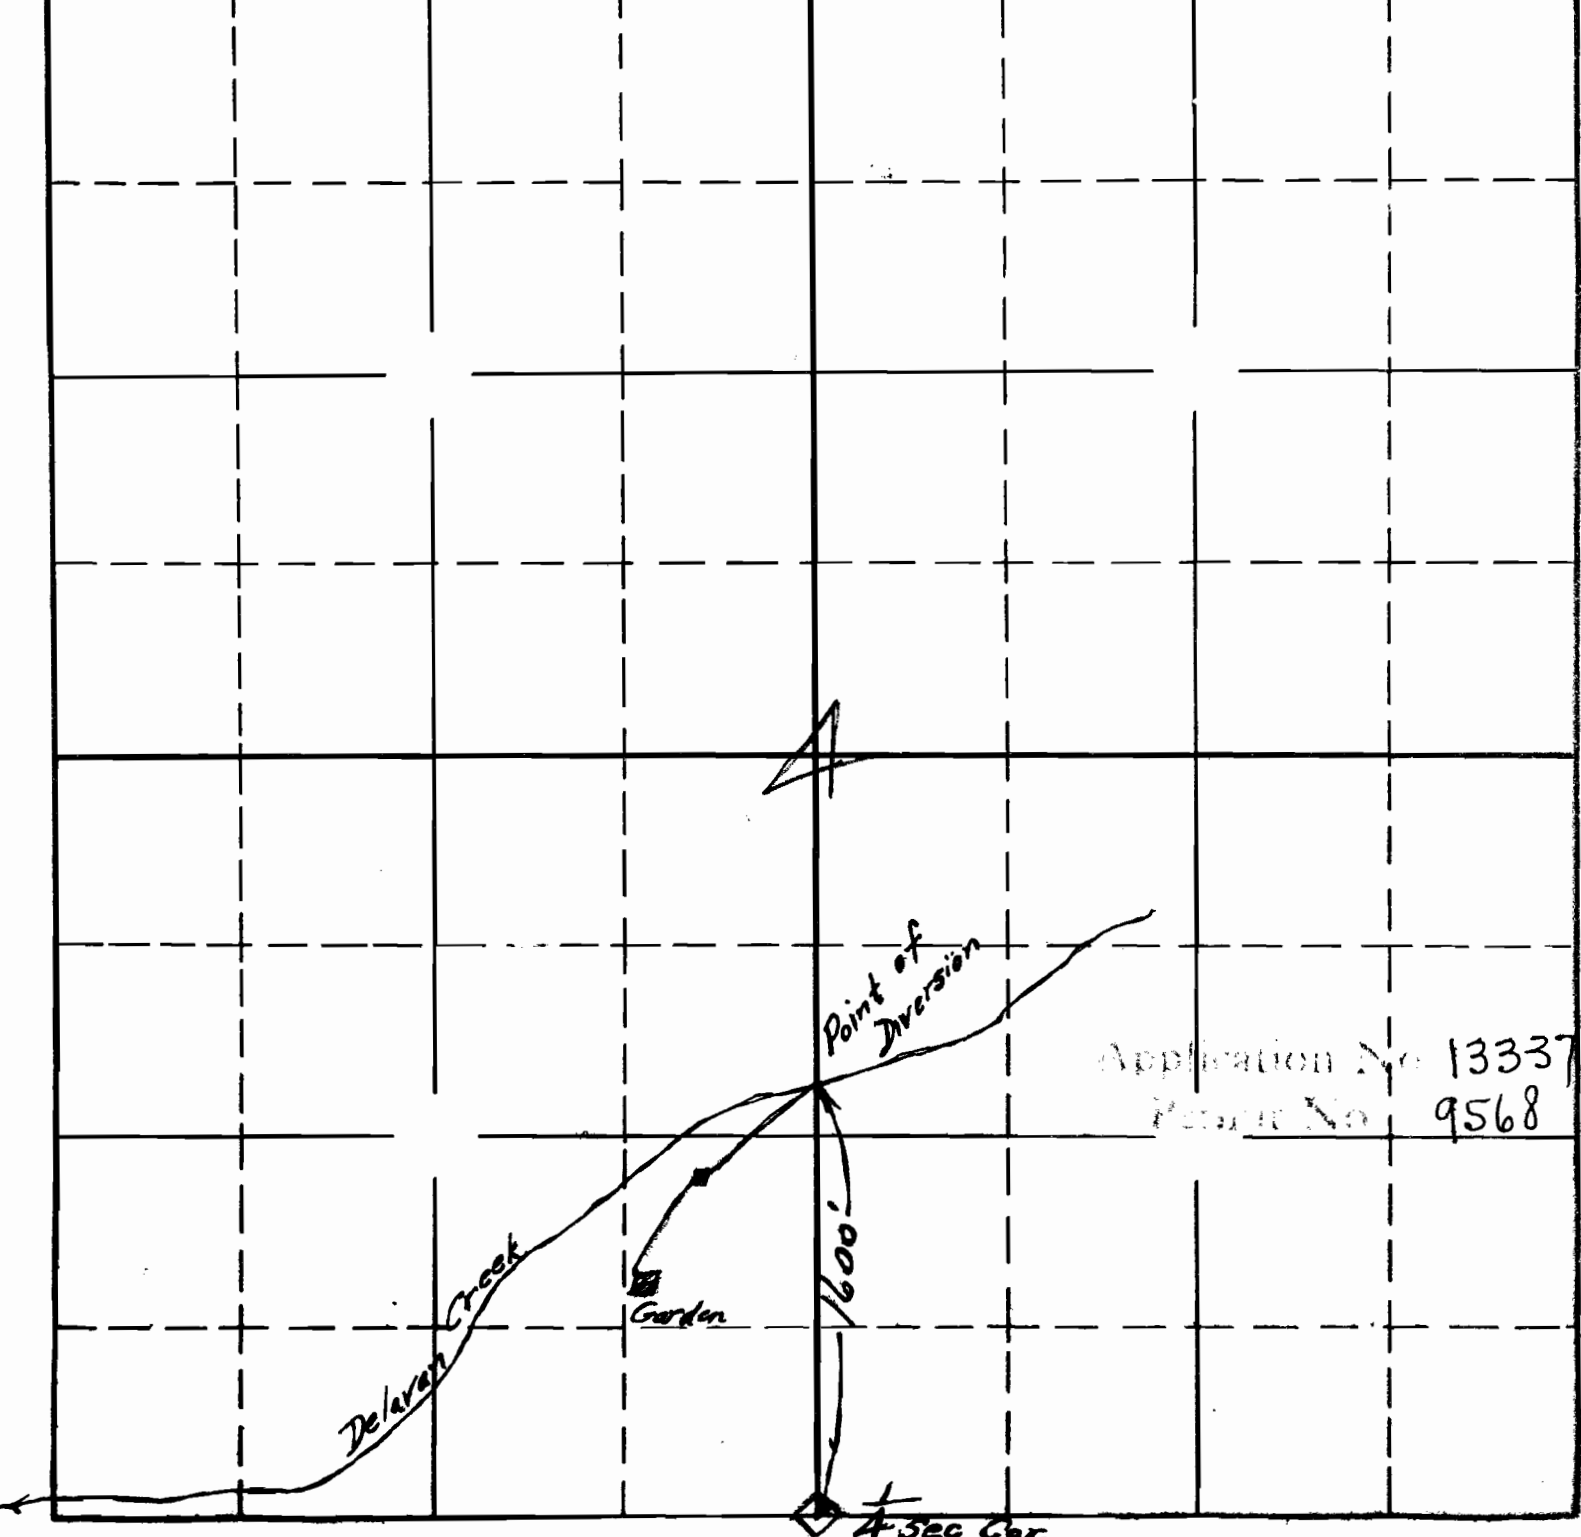

Application No. 13337
Permit No. 9568

4 sec Cor.