


Sec. 20

Tp. 36 S.

R. 4 W.

W.M.

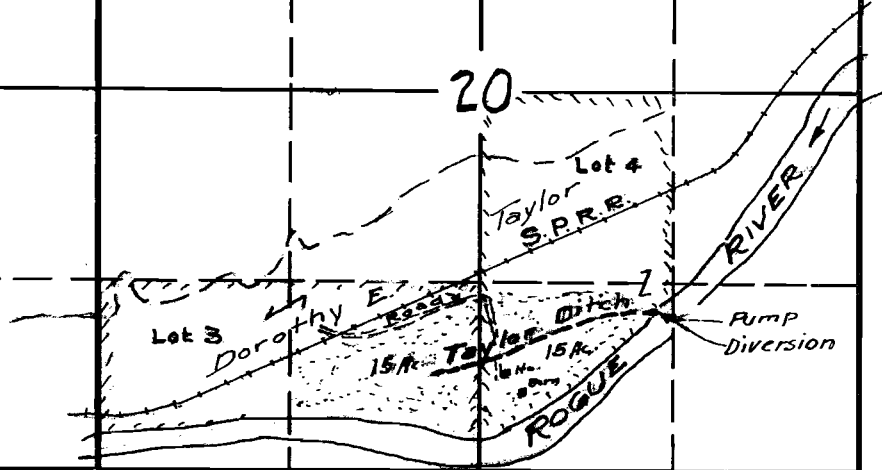


Application No. 13359

Permit No. 9586

MAP

Accompanying Final Proof of Permit No 9586 in the name of Dorothy E Taylor of Rogue River Oregon to the waters of Rogue River for Irrigation purposes

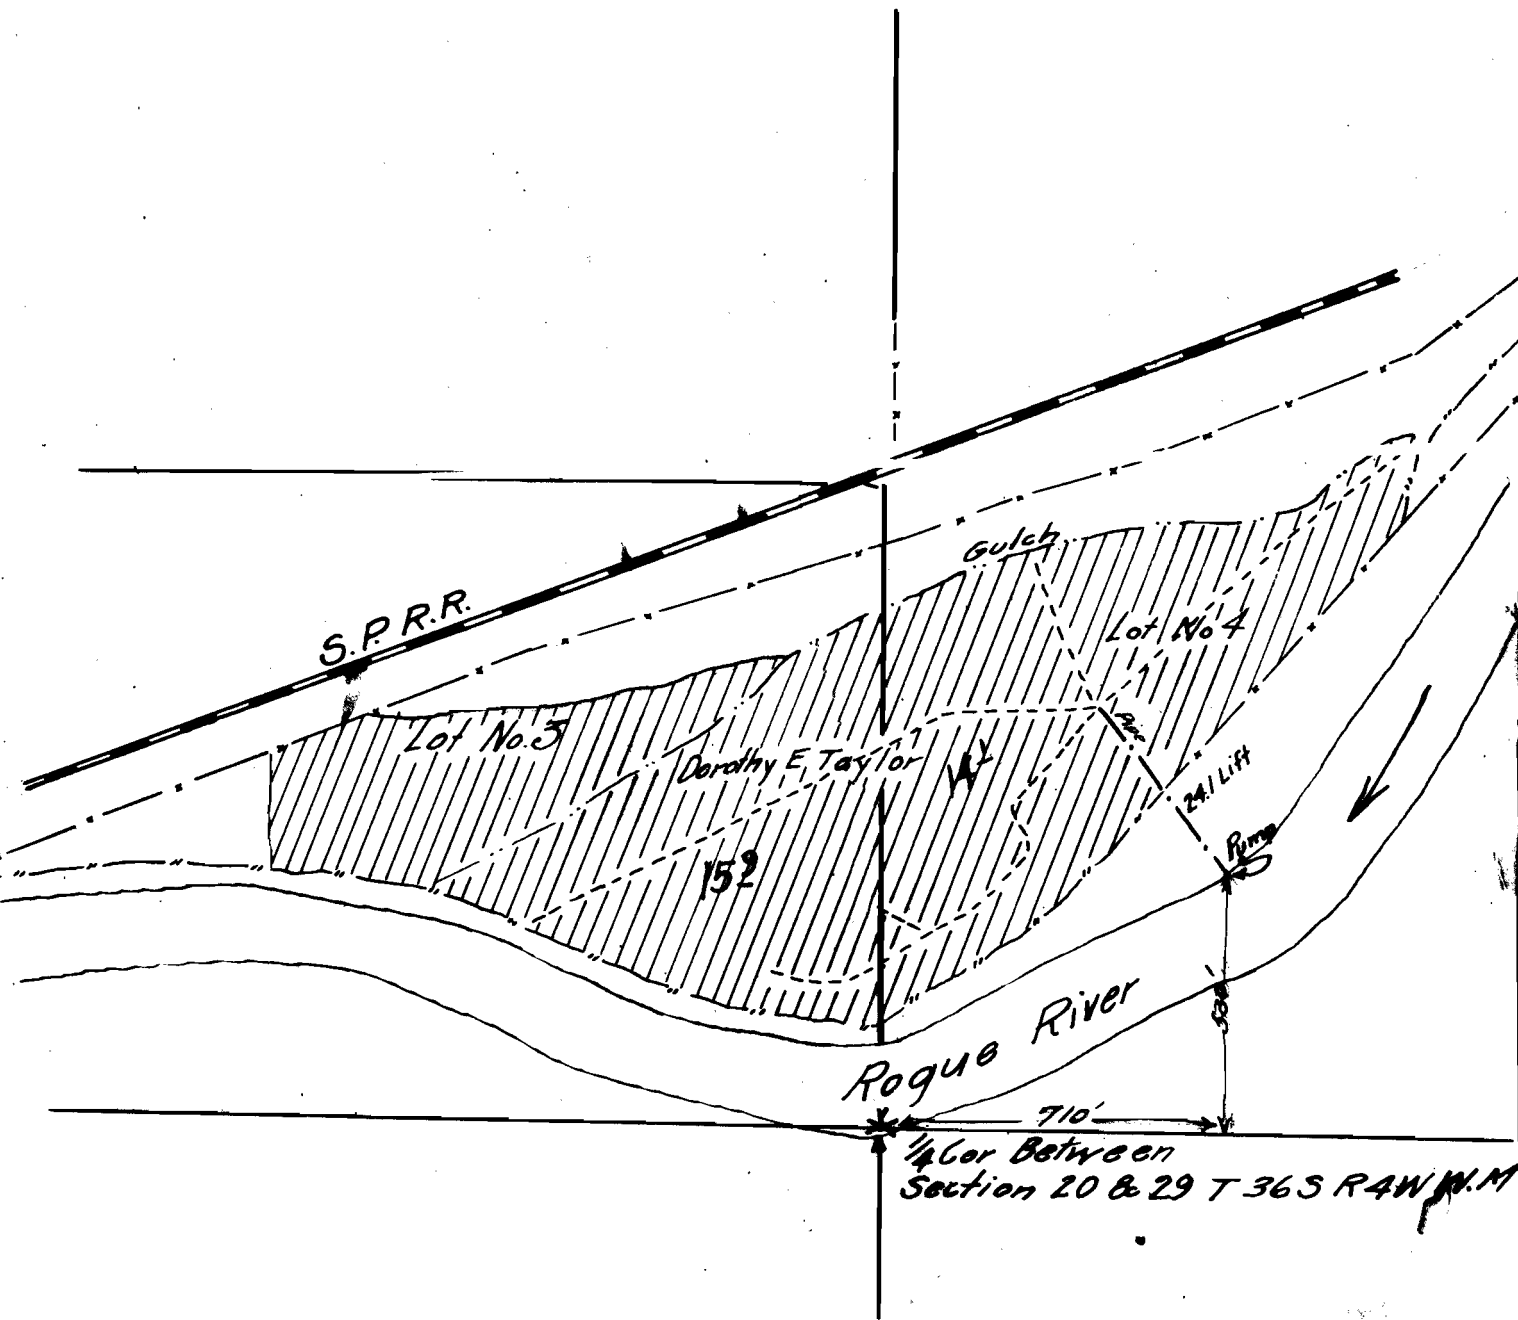

Map made by Chester Cummings