


2000 ft. wide

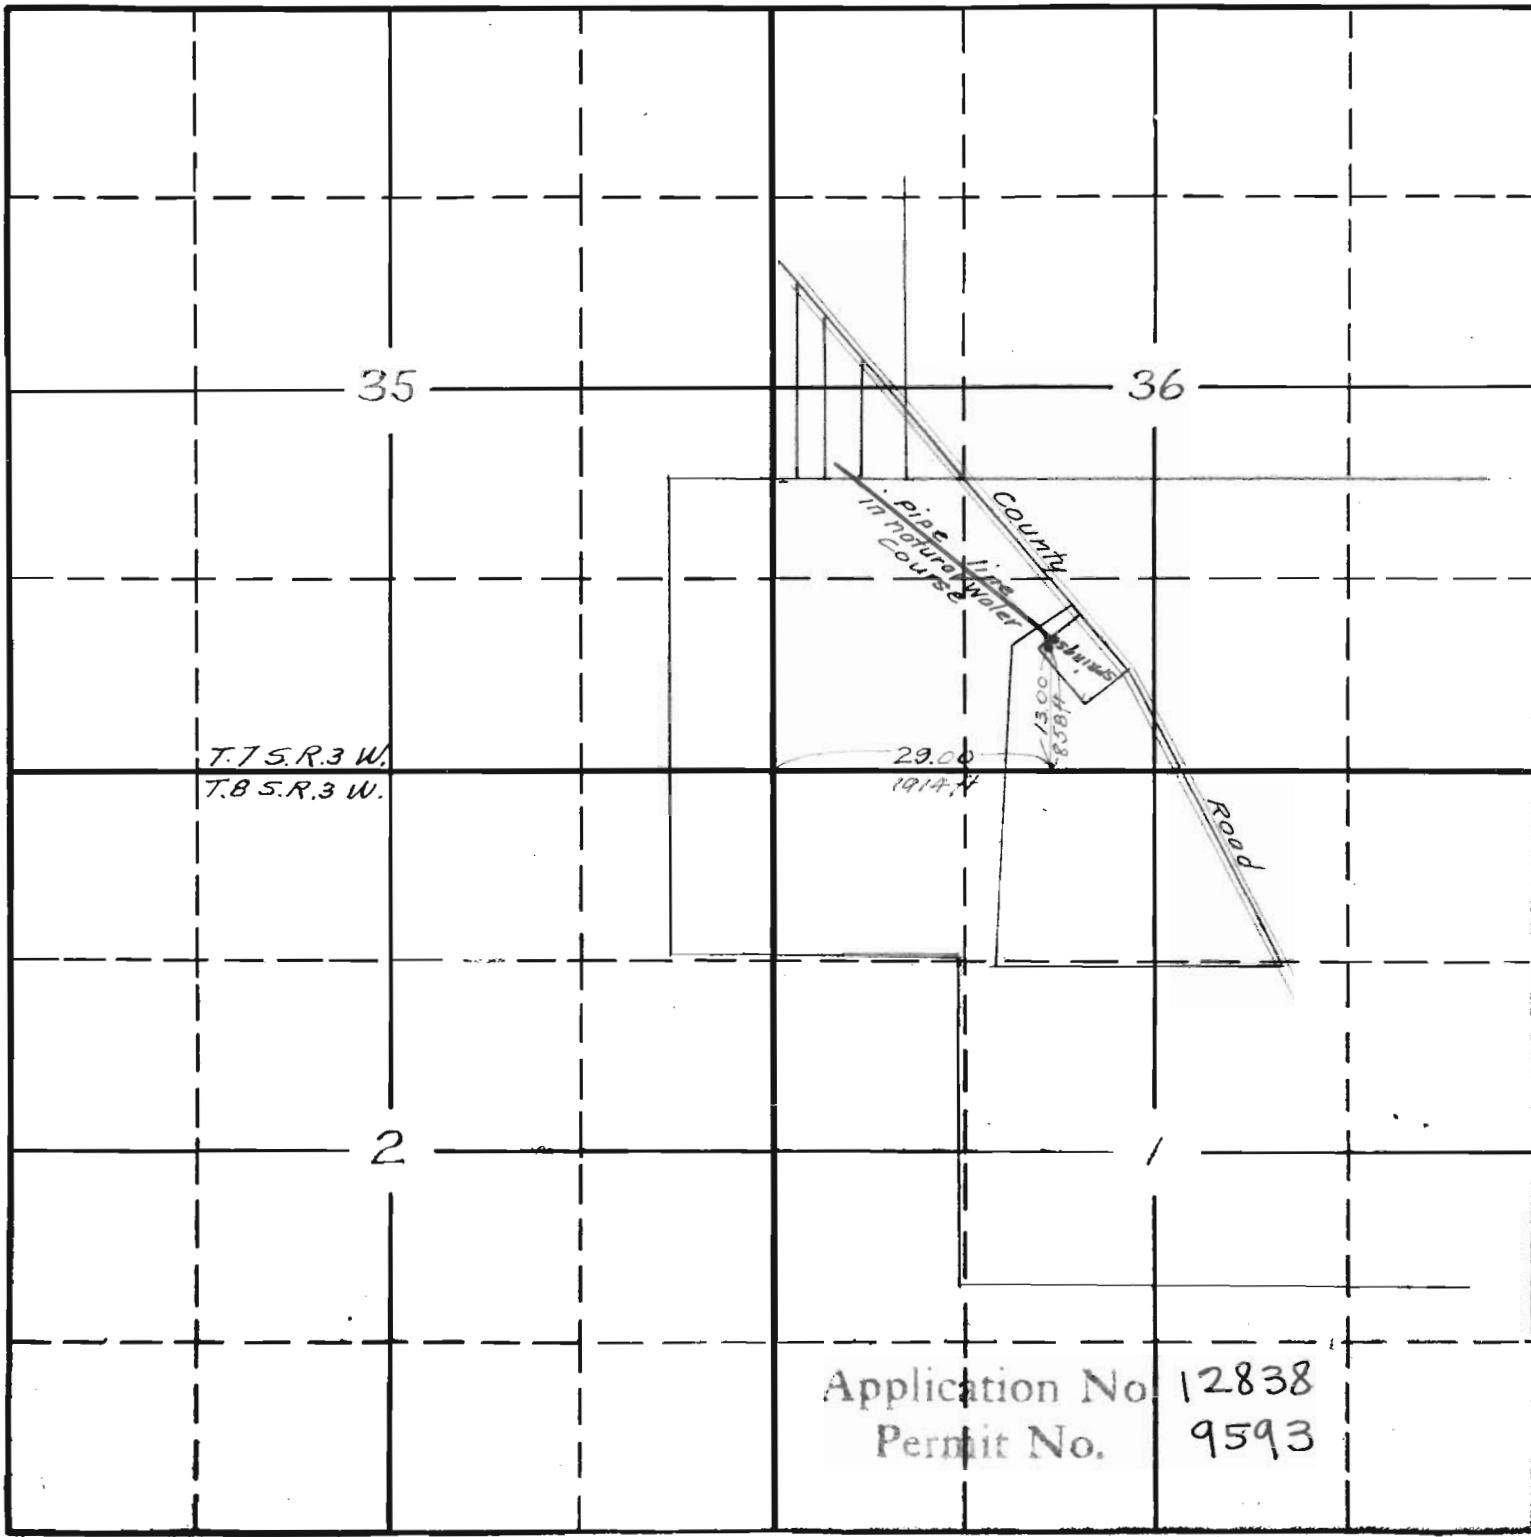

Sec. 36

Tp. 7 S.

R. 3 W.

T. 7 S. R. 3 W.
T. 8 S. R. 3 W.

Application No. 12838
Permit No. 9593