


Sec. 3

Tp. 3S

R. 2E

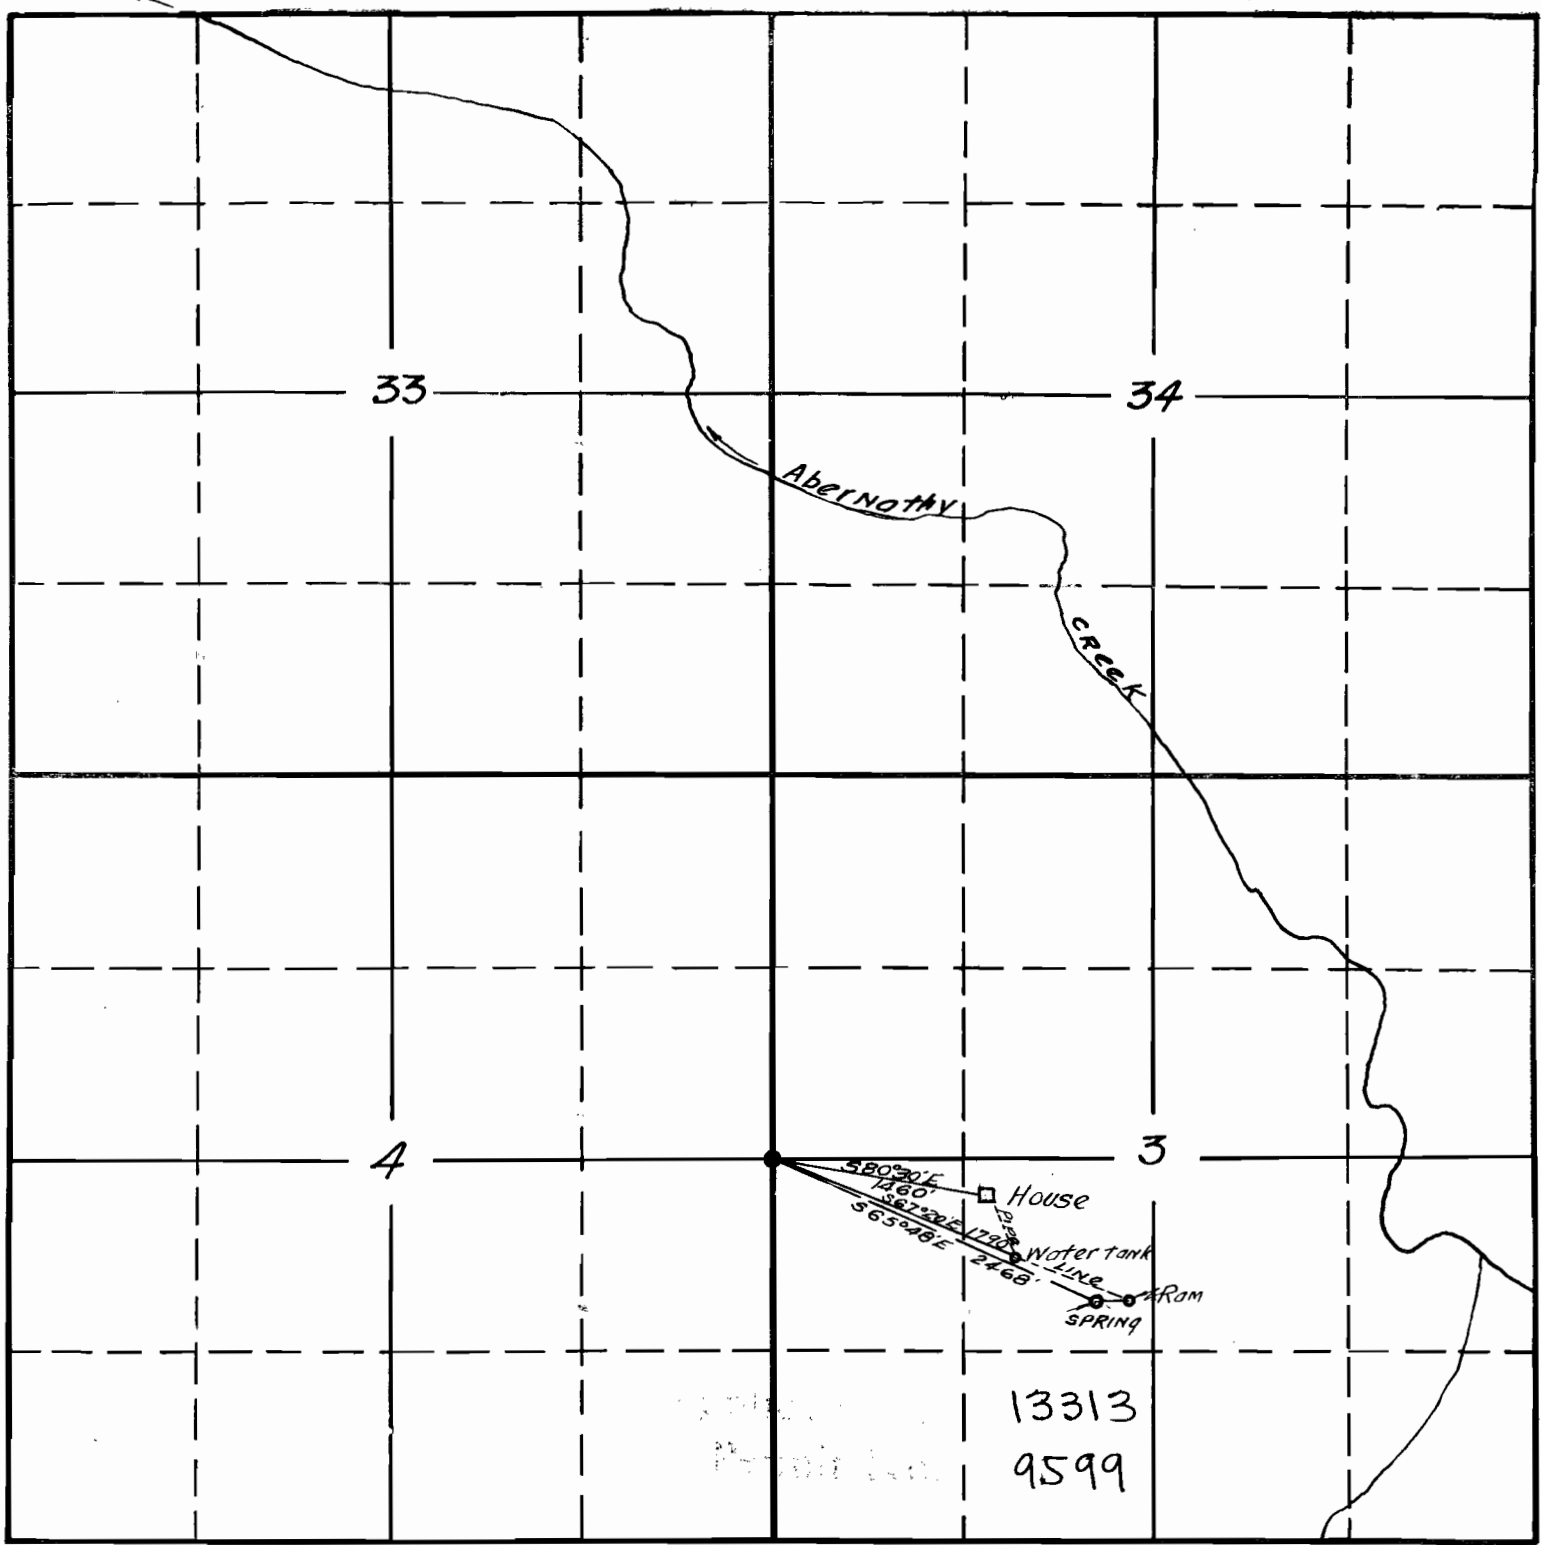

I, L. F. Holliday, do hereby certify that the within map was made from notes taken during an actual survey made under my supervision during the month of February, 1927.

L. F. Holliday
Reg. No. 5521