



MAP
SHOWING
LOCATION
OF
L.B. SMITH
SPRINGS.

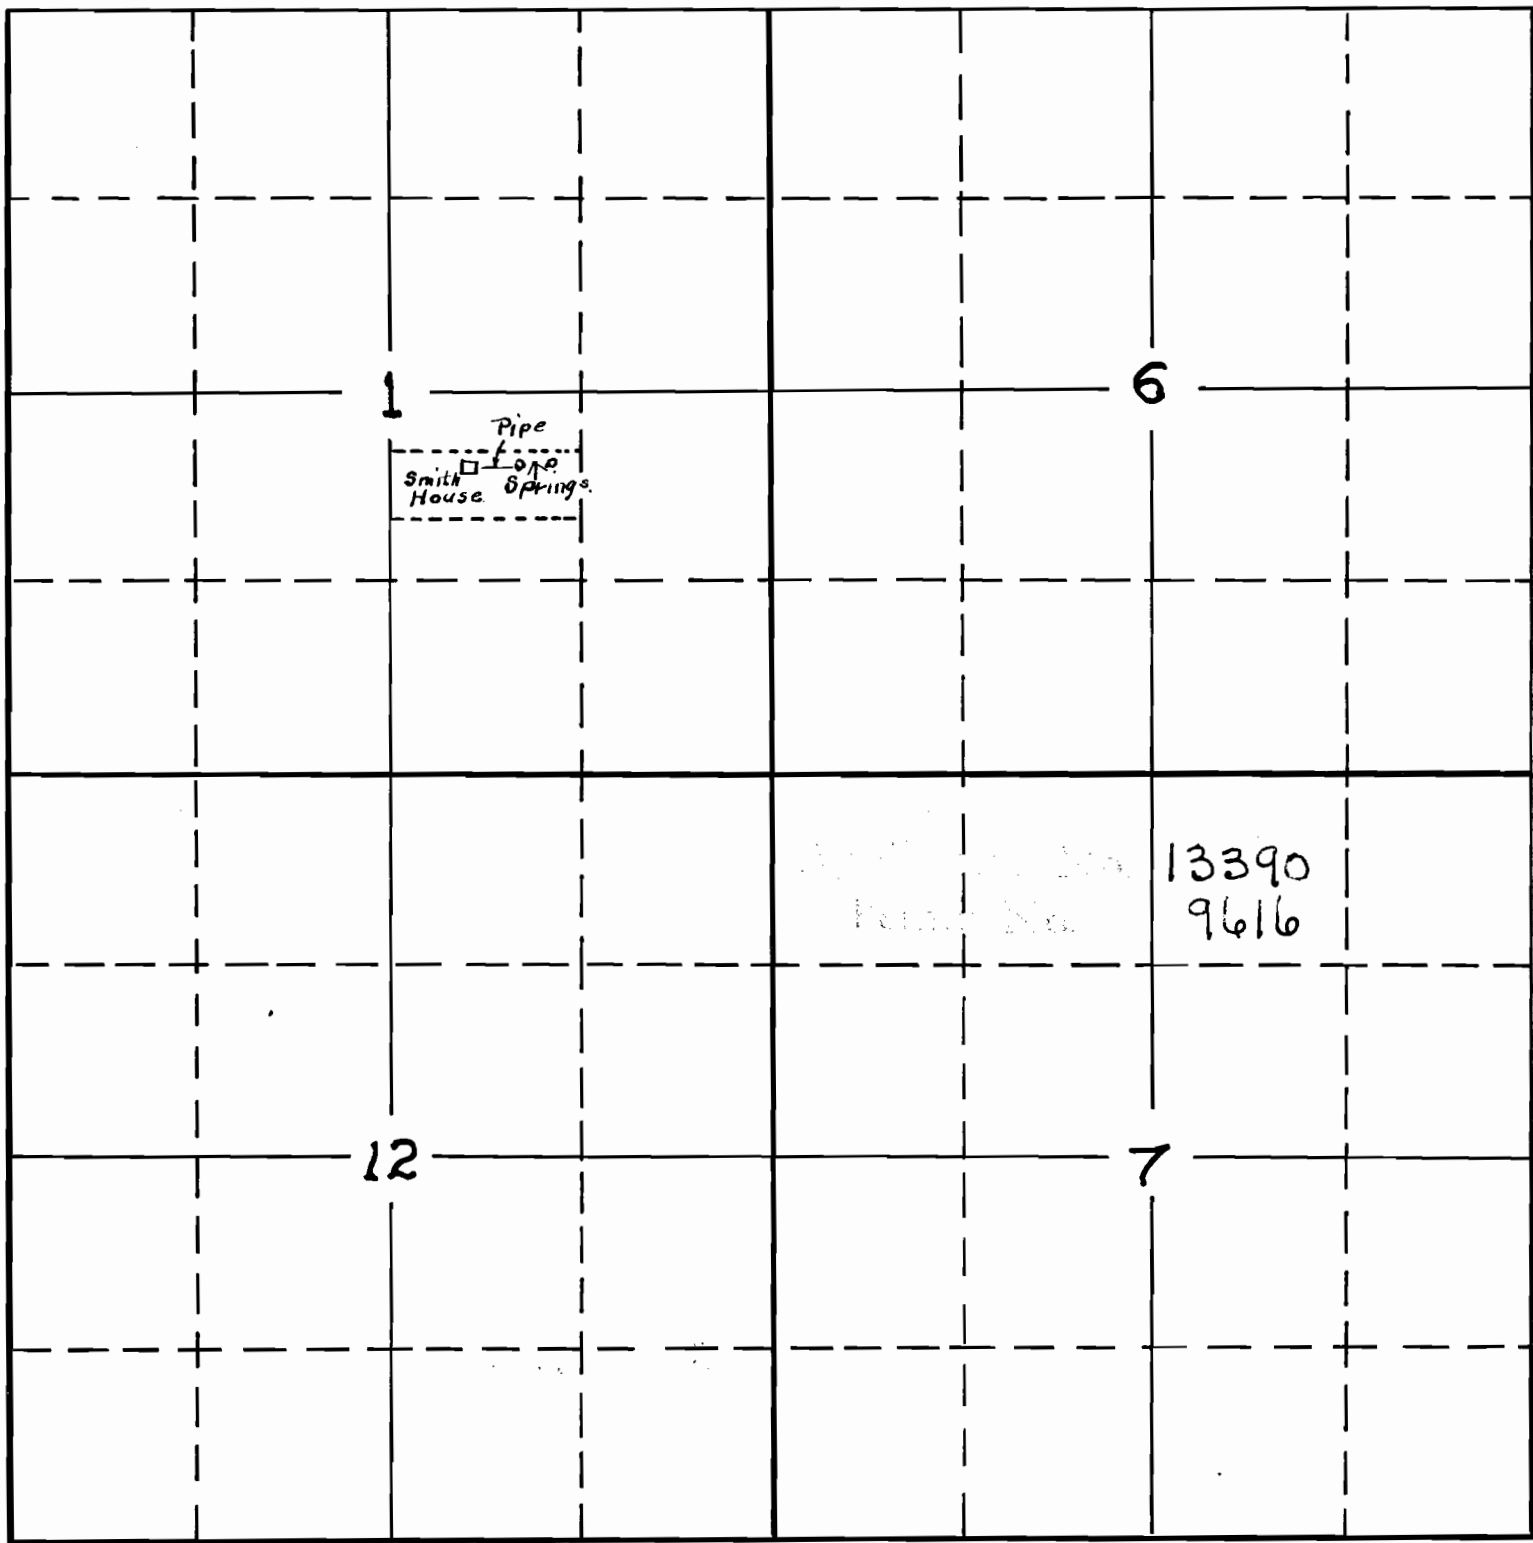

Sec. 1

Tp. 2 S.
R. 4 E.

Application No. 13390
Permit No. 9616

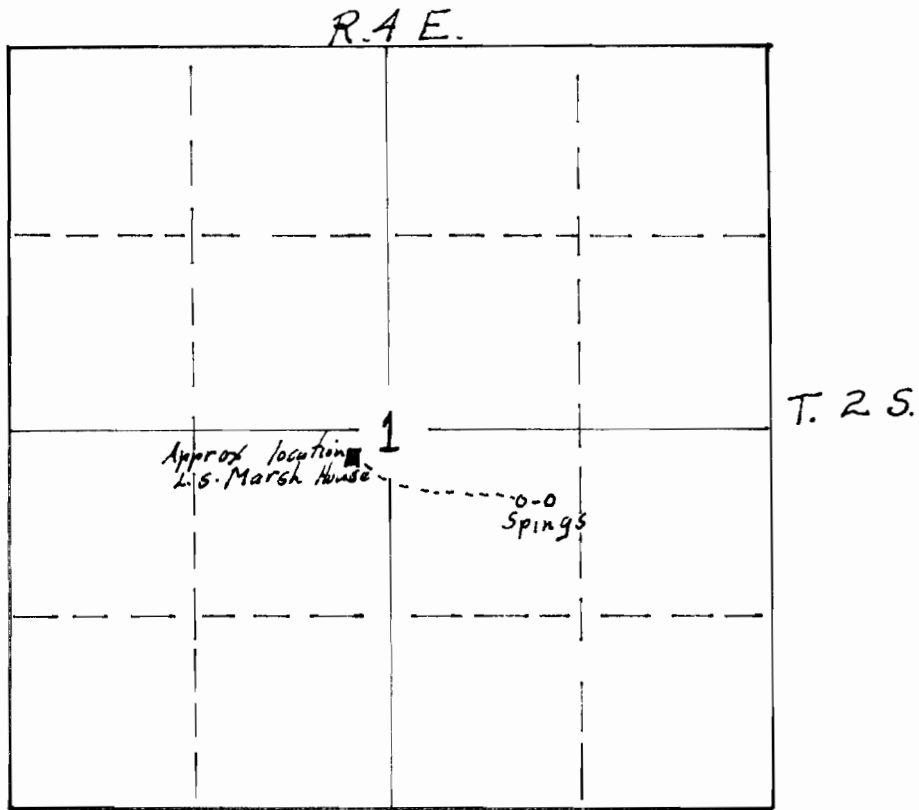

Pipe line built to house located in the NE Cor. of the NESW Sec. 1 instead of the house location shown on original Application Map

sketched from original Appl. Map and information Affidavit of Appropriation