


Township one (1) South
Range one (1) East Willamette Meridian

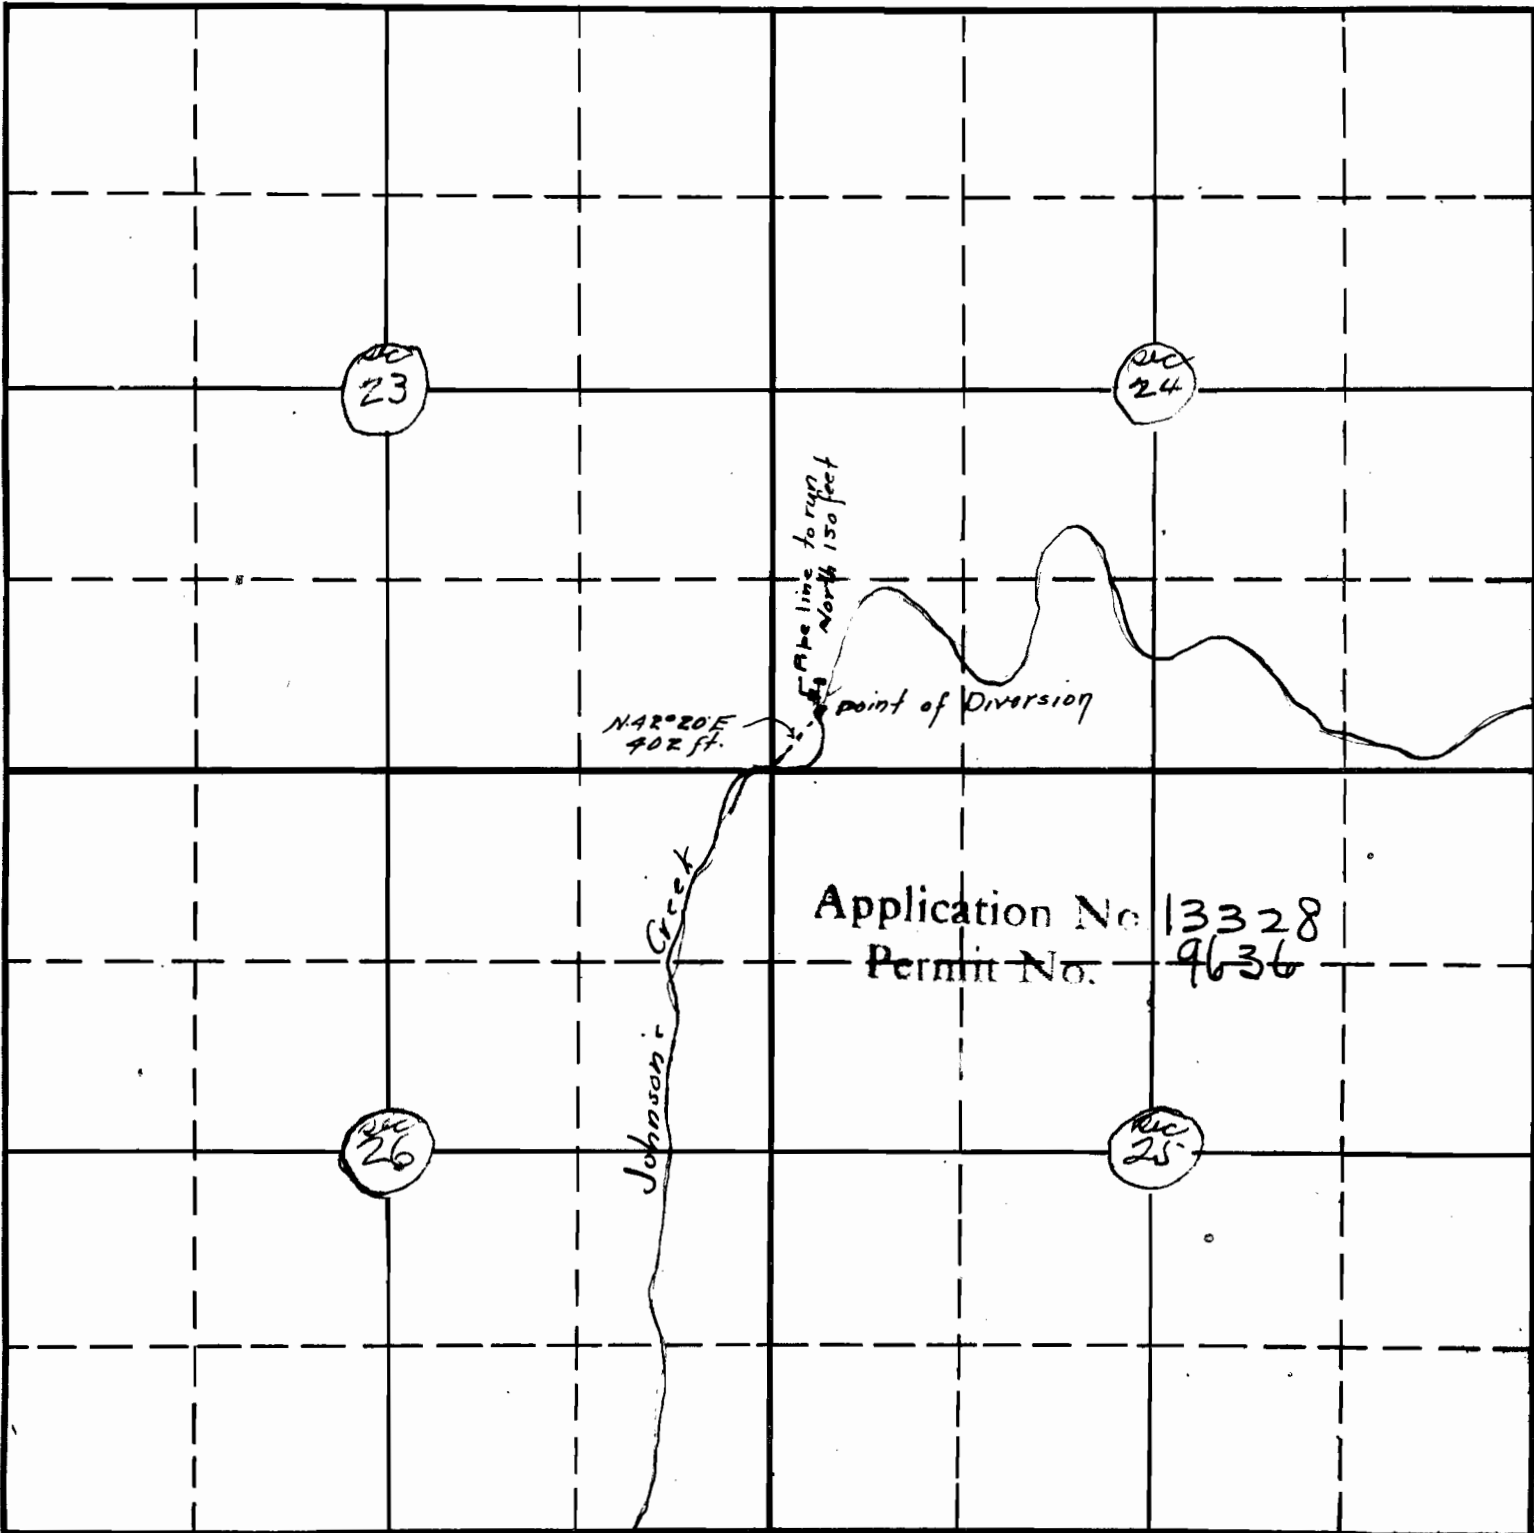

N42°20'E
402 ft.

to the line to rgn
North 150 feet

point of Diversion

Application No. 13328
Permit No. 9636

Sec 26

Sec 25

Sec 23

Sec 24

Johnson Creek

Sec. 24
Tp. 1 S
R. 1 E. 2 W.