


SECTION

TOWNSHIP 8 S, RANGE 6 W, W. M.

North

West

East

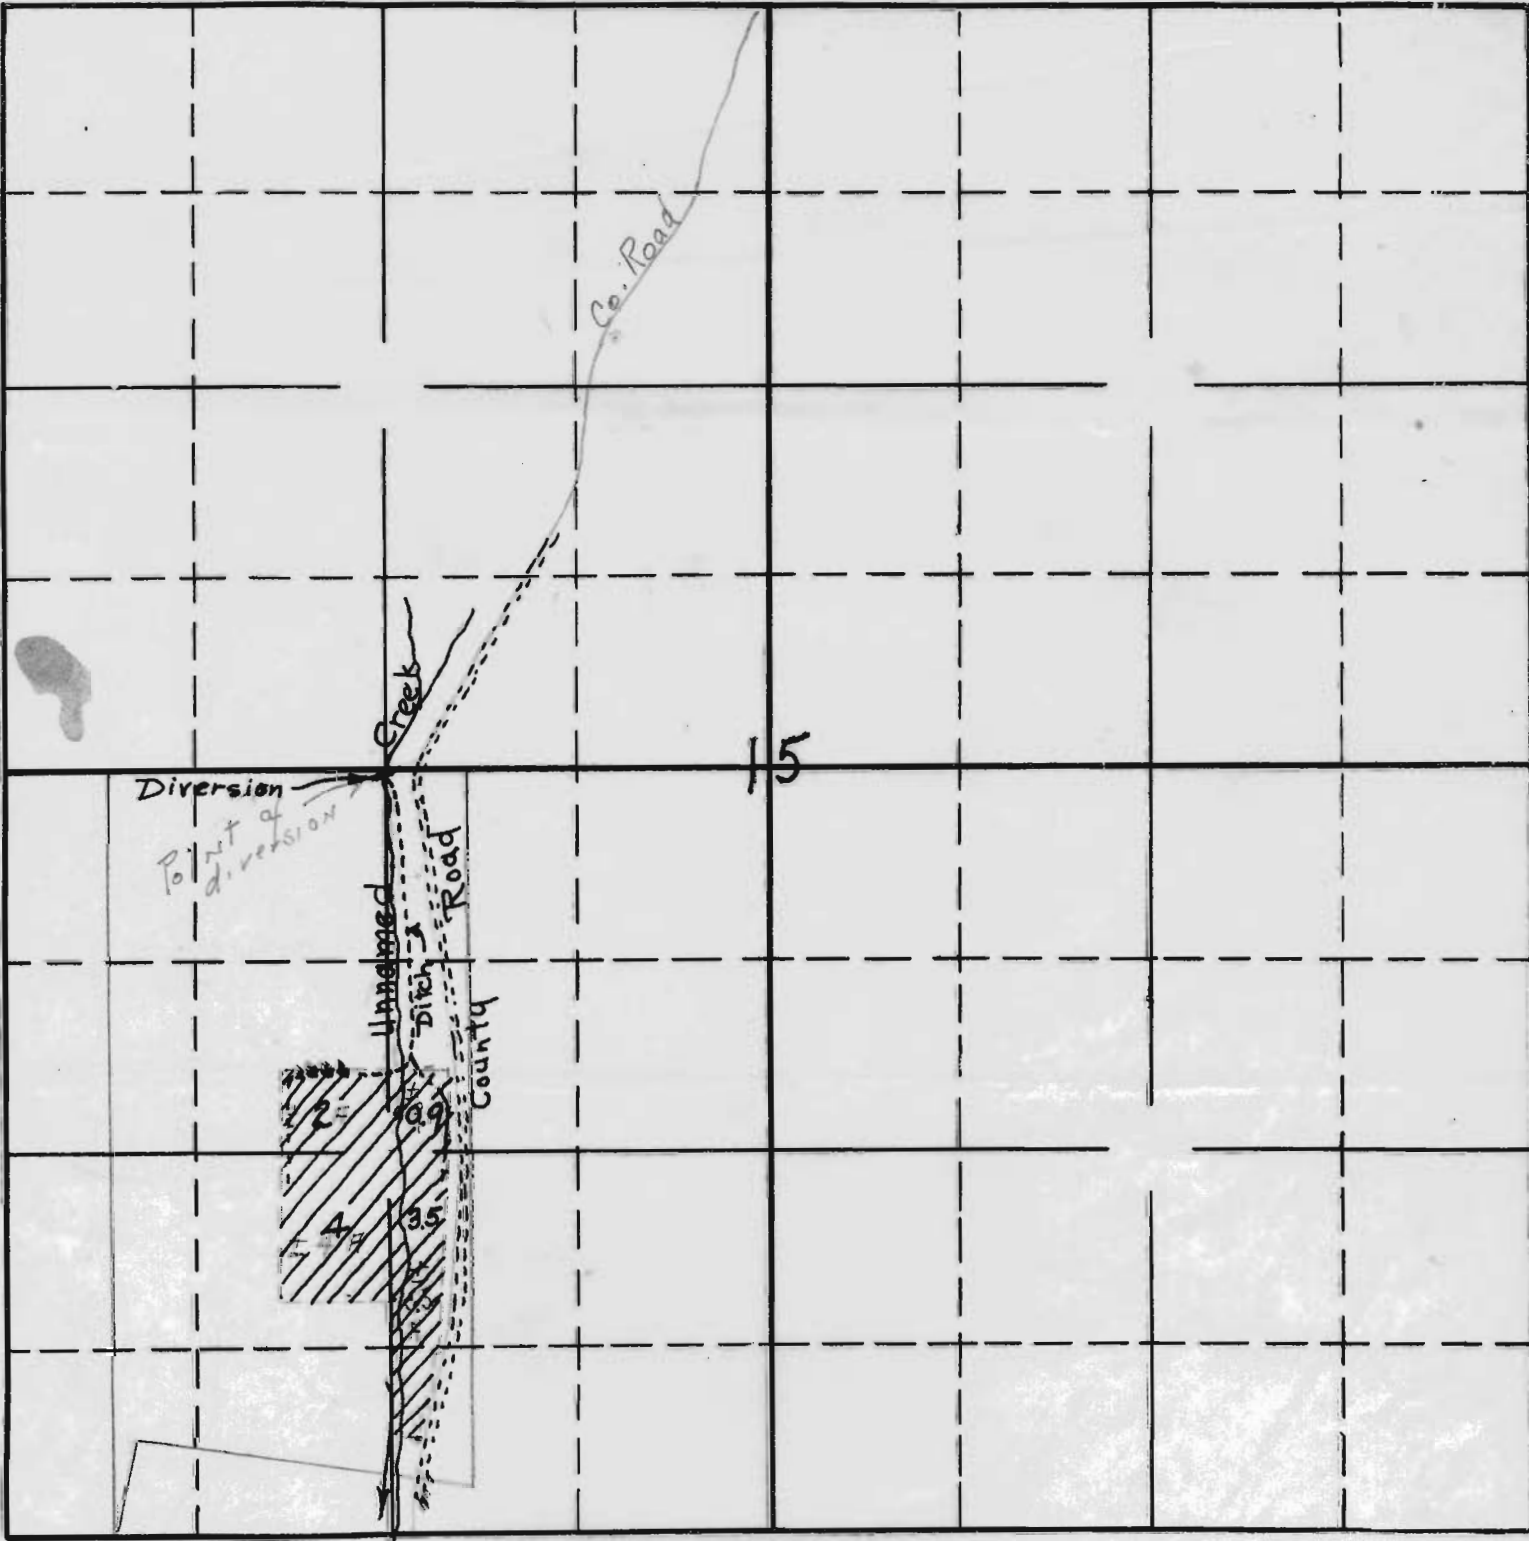

South

APPLICATION No. 13436
PERMIT No. 9648