


Sec. 15

16

Tp. 35

R. 2W

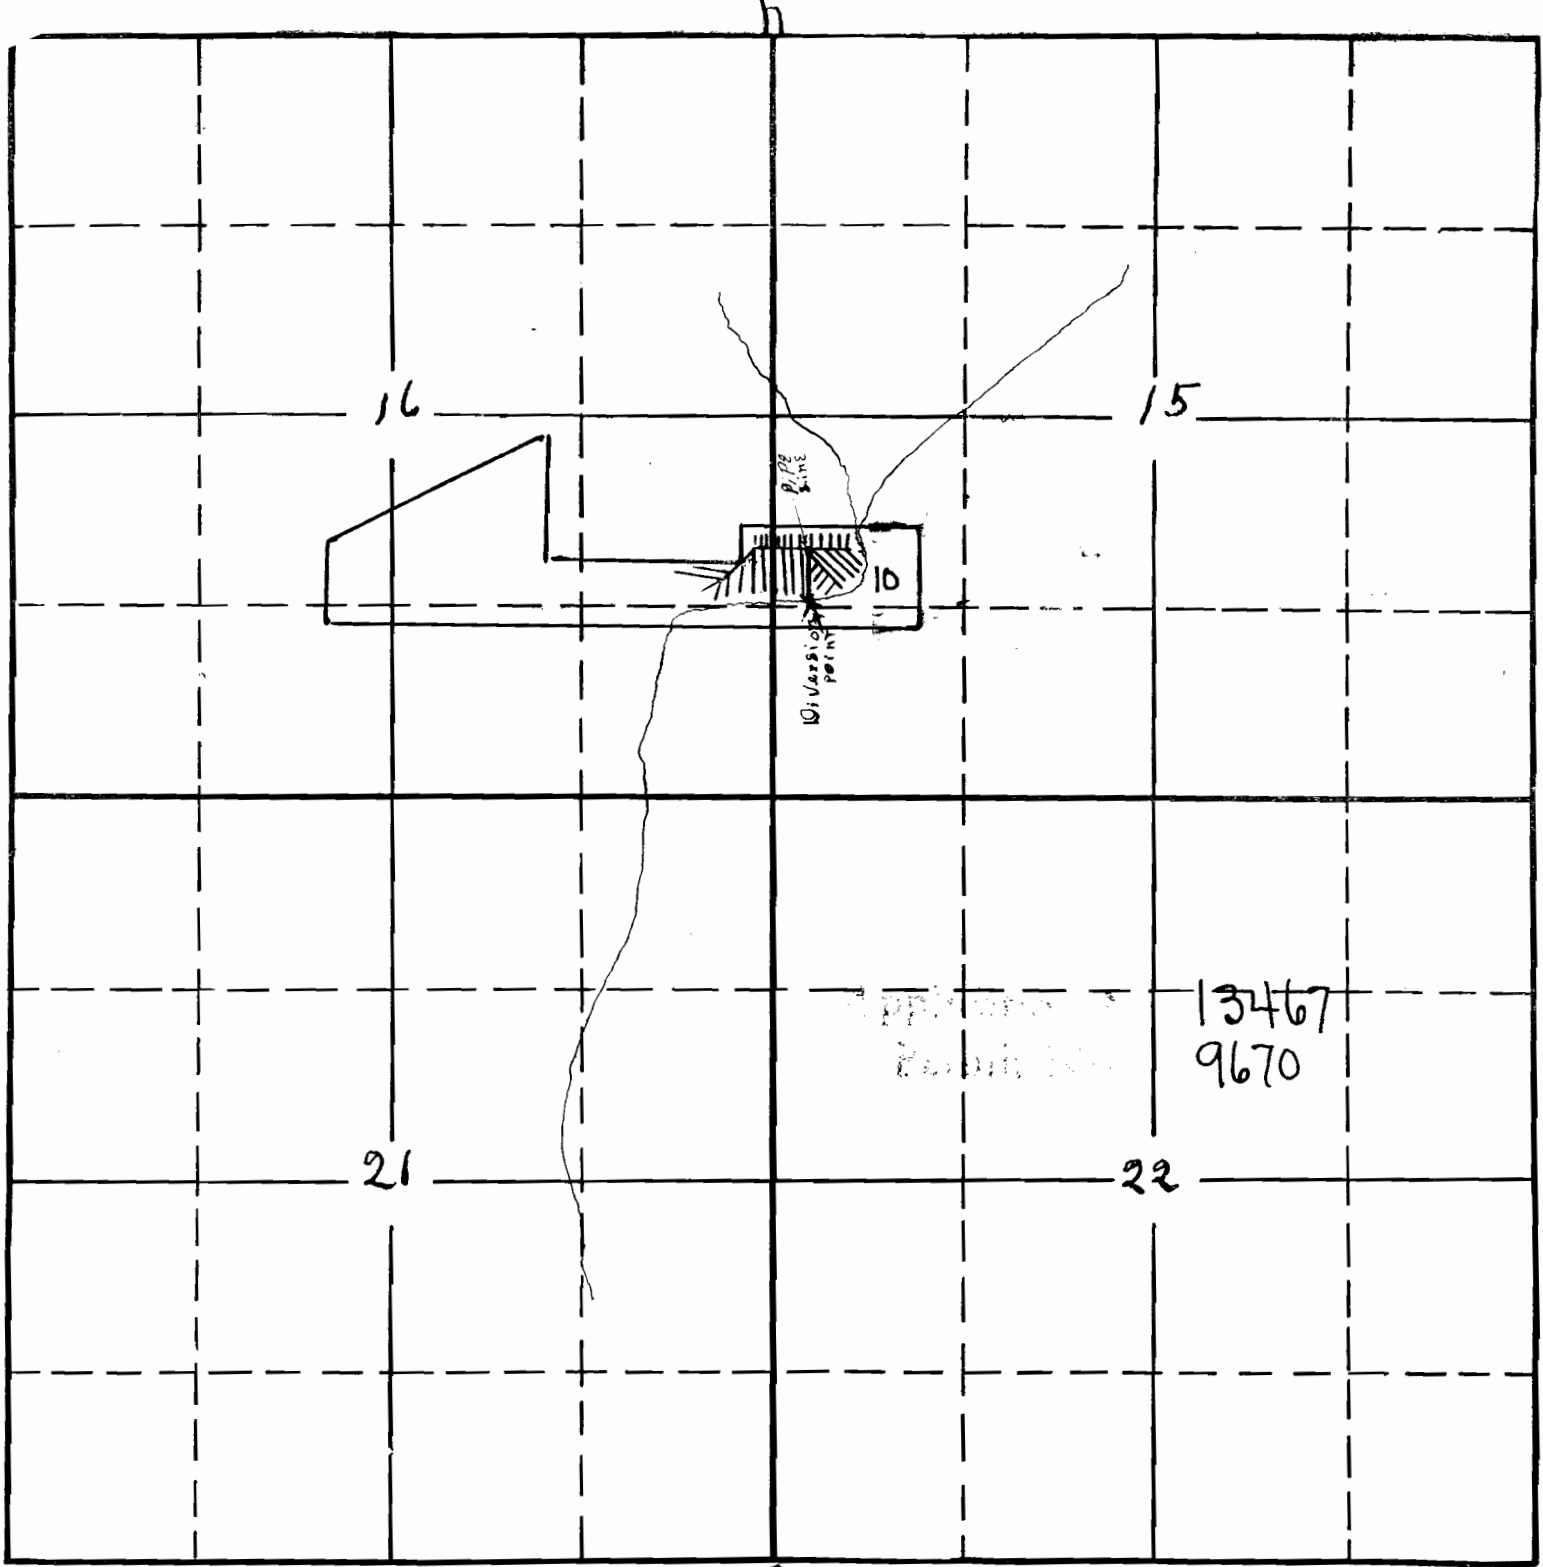

W

E

S

Applicant's
Return No.

13467

9670

16

15


10

Pipe
Line

Diversion
point

SECTION

TOWNSHIP 3 S, RANGE 2 W, W. M.

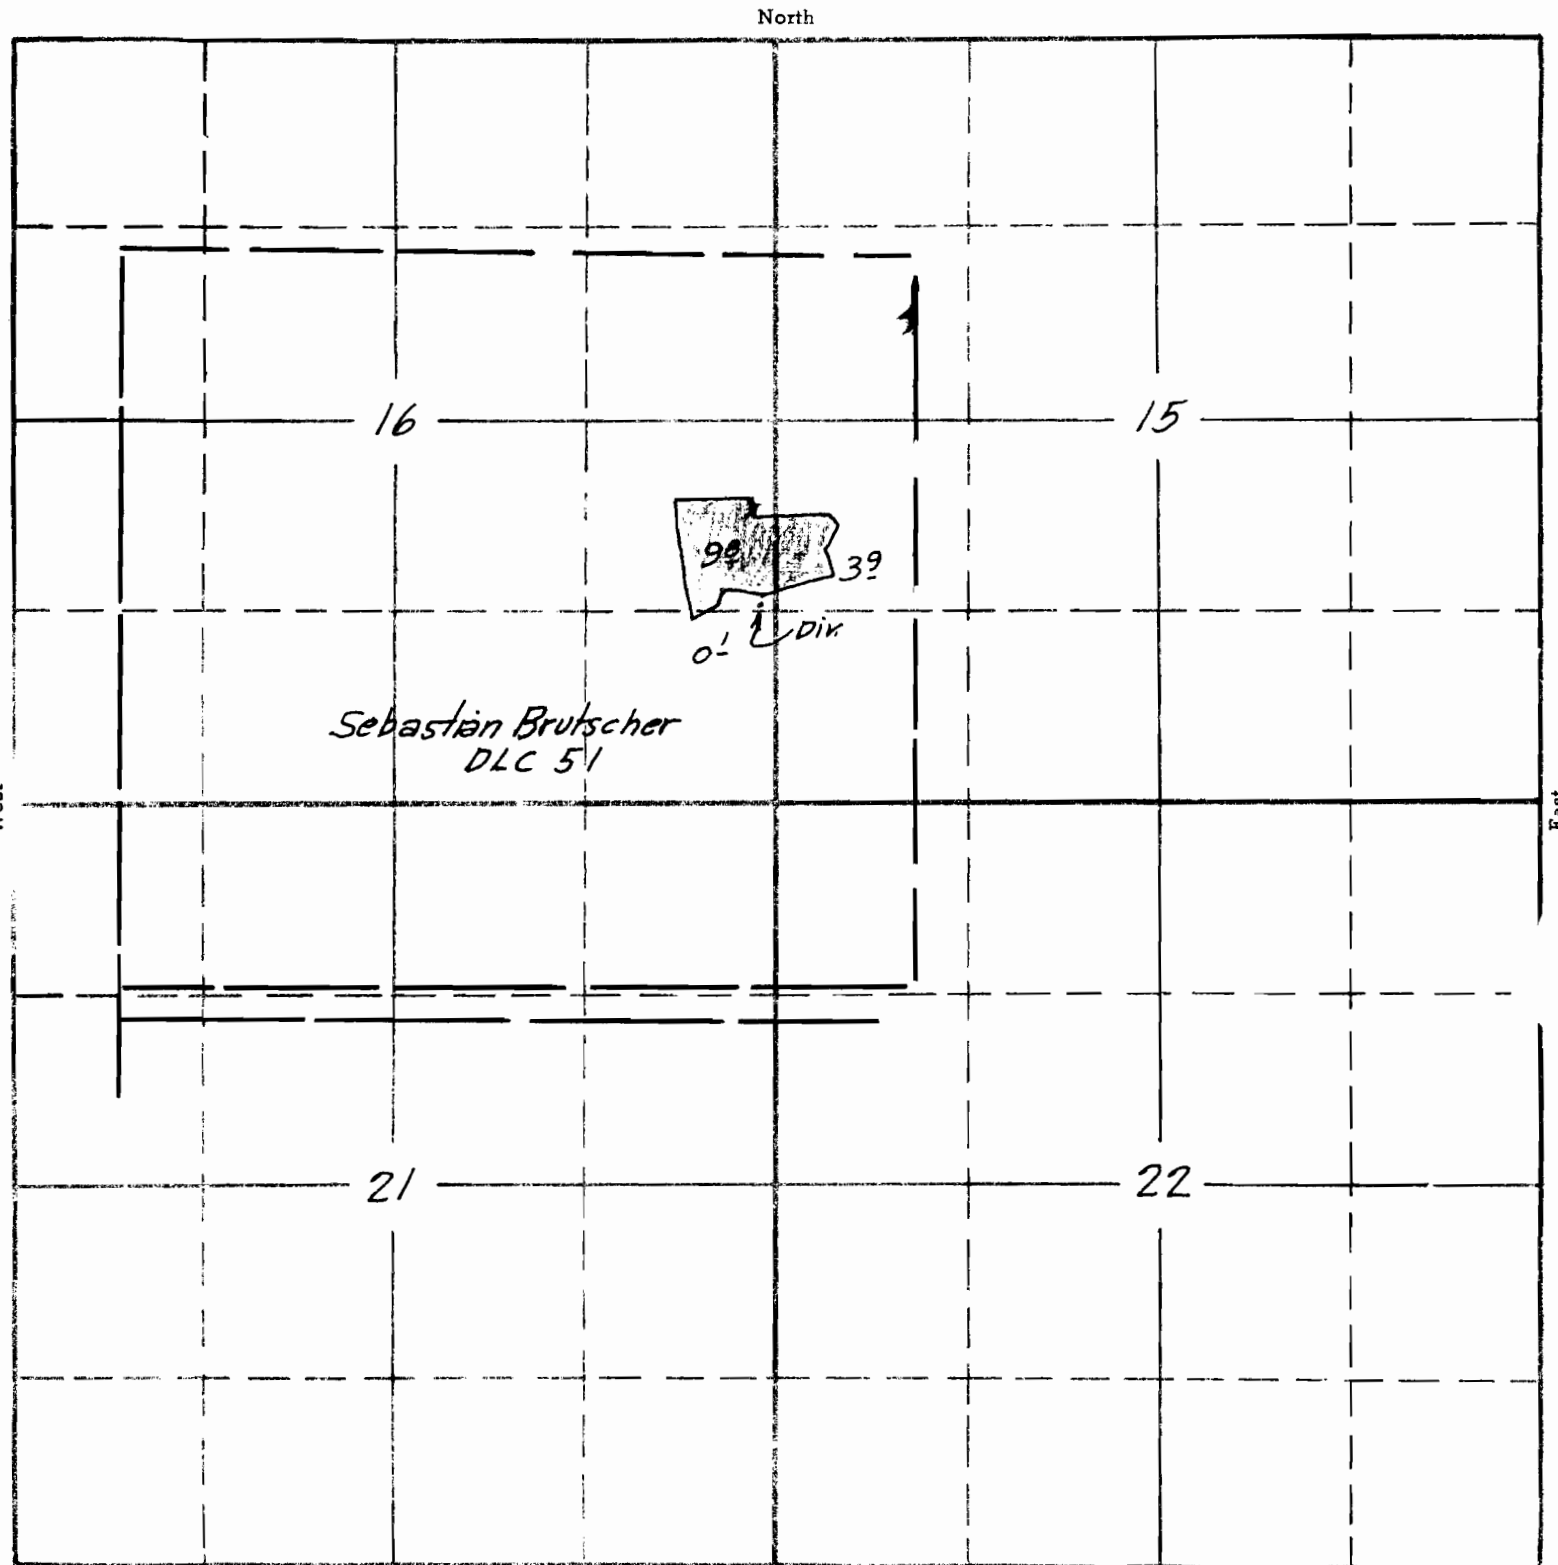

Surveyed June 8 1940 C.A.C.

South

APPLICATION No. 13467

PERMIT No. 9670