


SECTION

25

36

TOWNSHIP 6 N, RANGE 35 E, W. M.

North

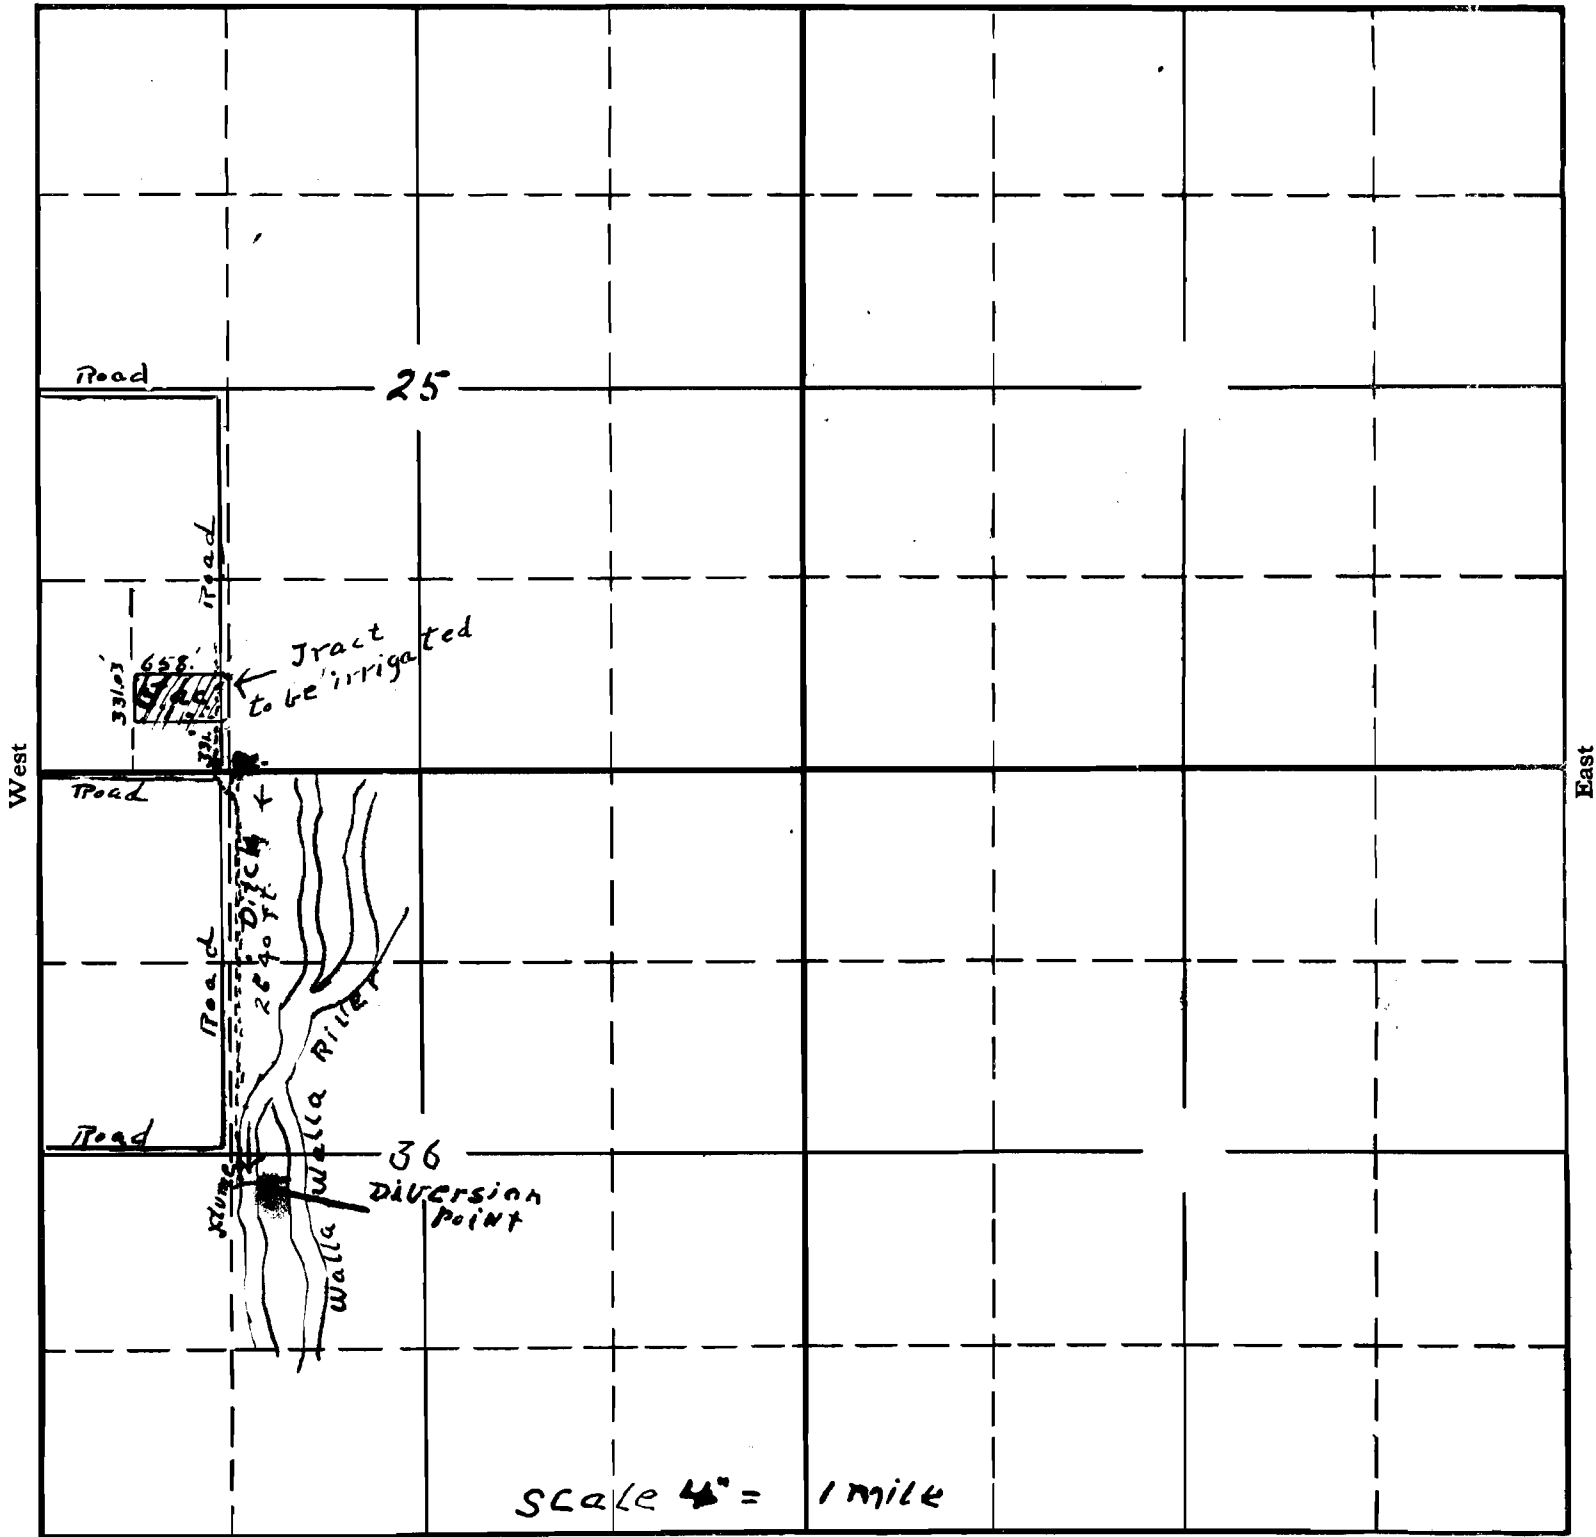

Map to accompany
Application for Water
of
Gleaves Lacey

APPLICATION No. 13491
PERMIT No. 9686