

SECTION

TOWNSHIP ^{7 S}~~8 S~~, RANGE ^{and} ~~3 W~~, W. M.


North

West

East

33

34

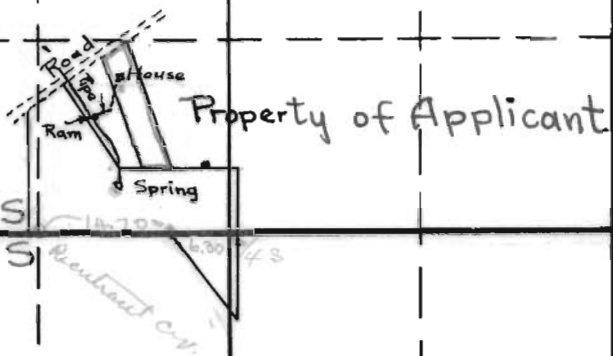

A

3

South

APPLICATION No. 13500

PERMIT No. 9710