


SECTION

10

TOWNSHIP 8 S., RANGE 2 W., W. M.

North

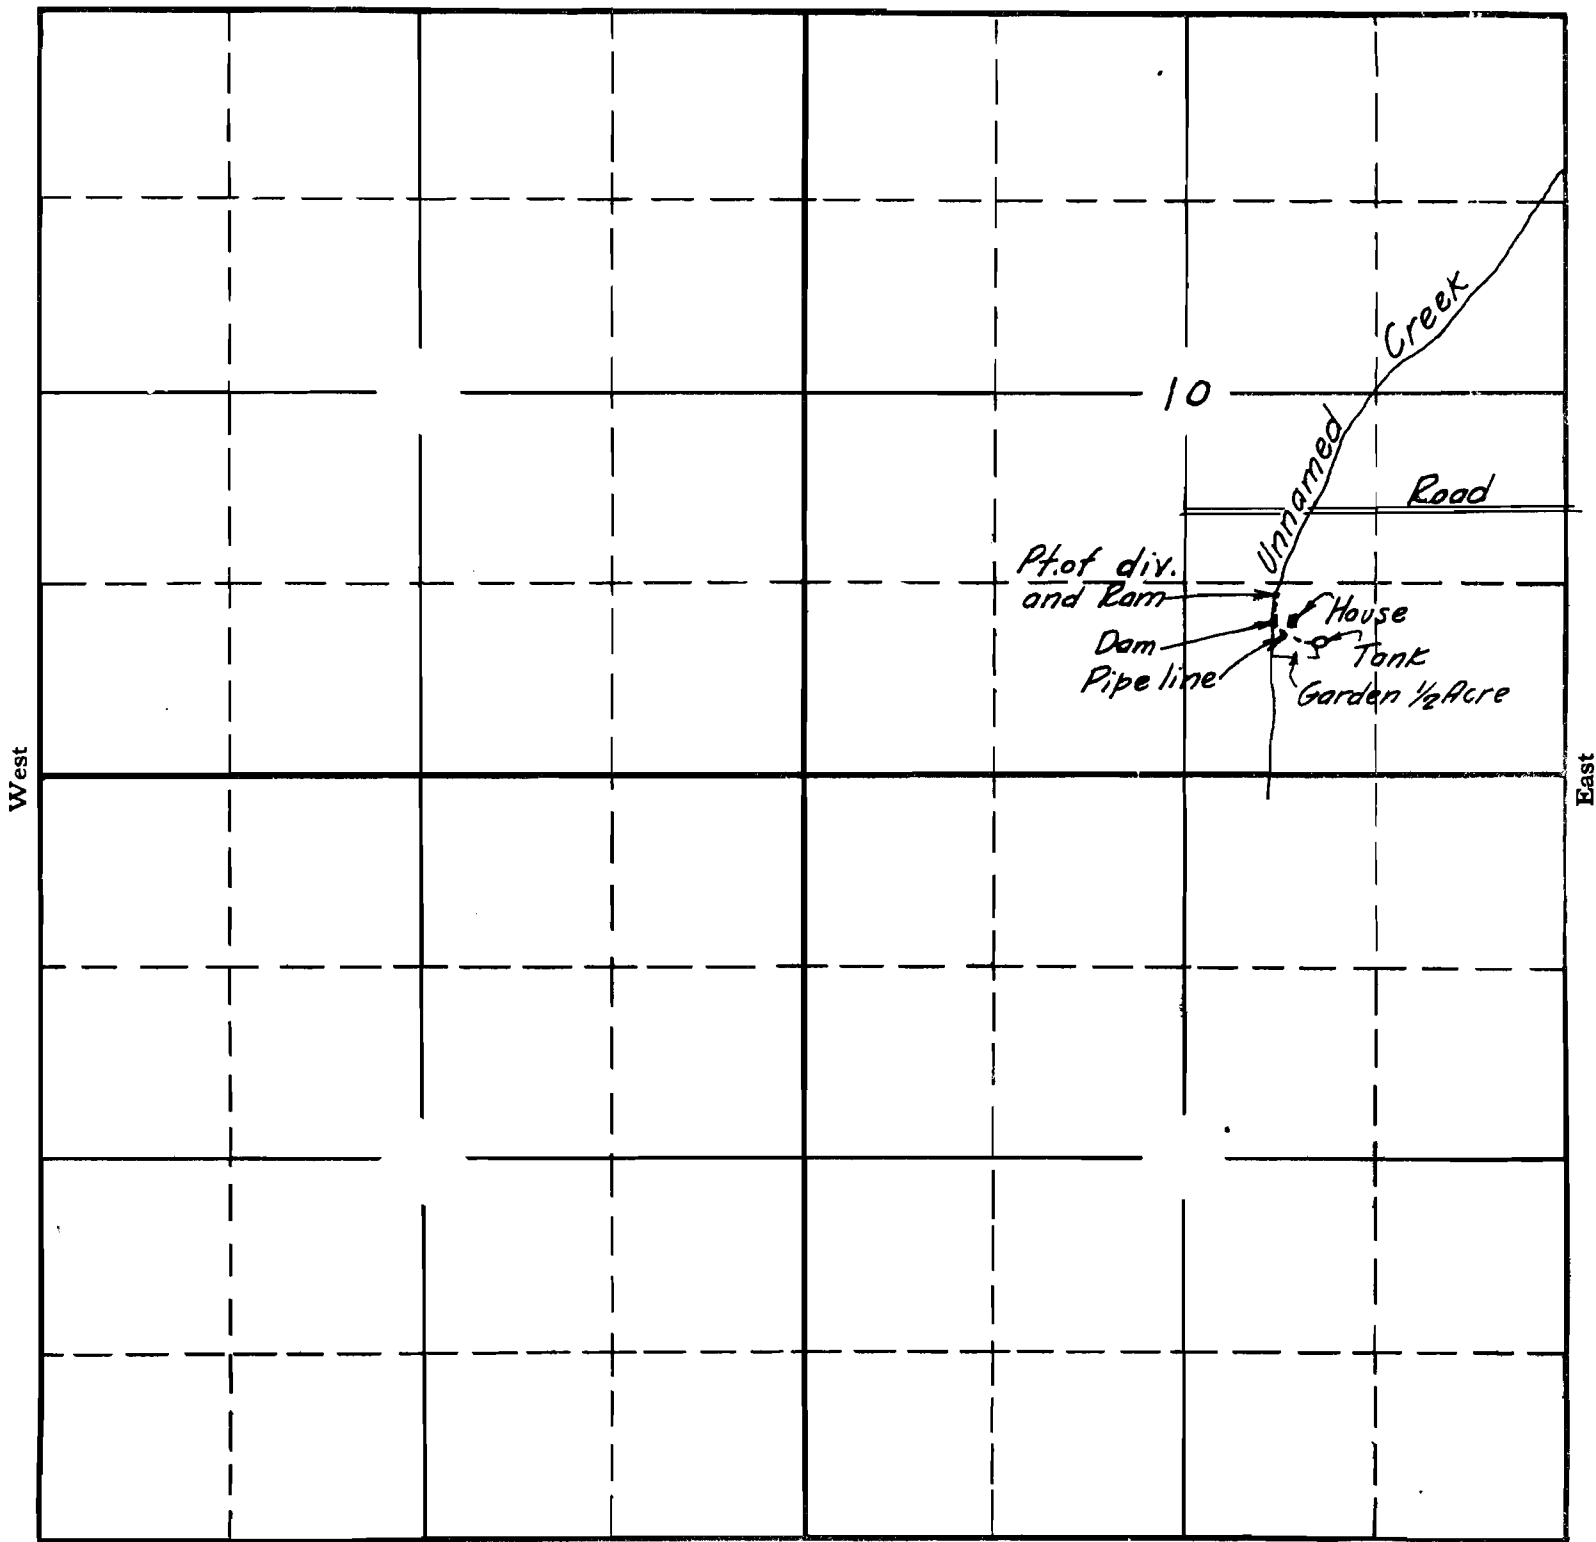

South

Map sketched from U.S. Quadrangle Sheet

APPLICATION No. 13505

PERMIT No. 9713