Plan of Water System of Popham-Meier Jewell-Oreg.

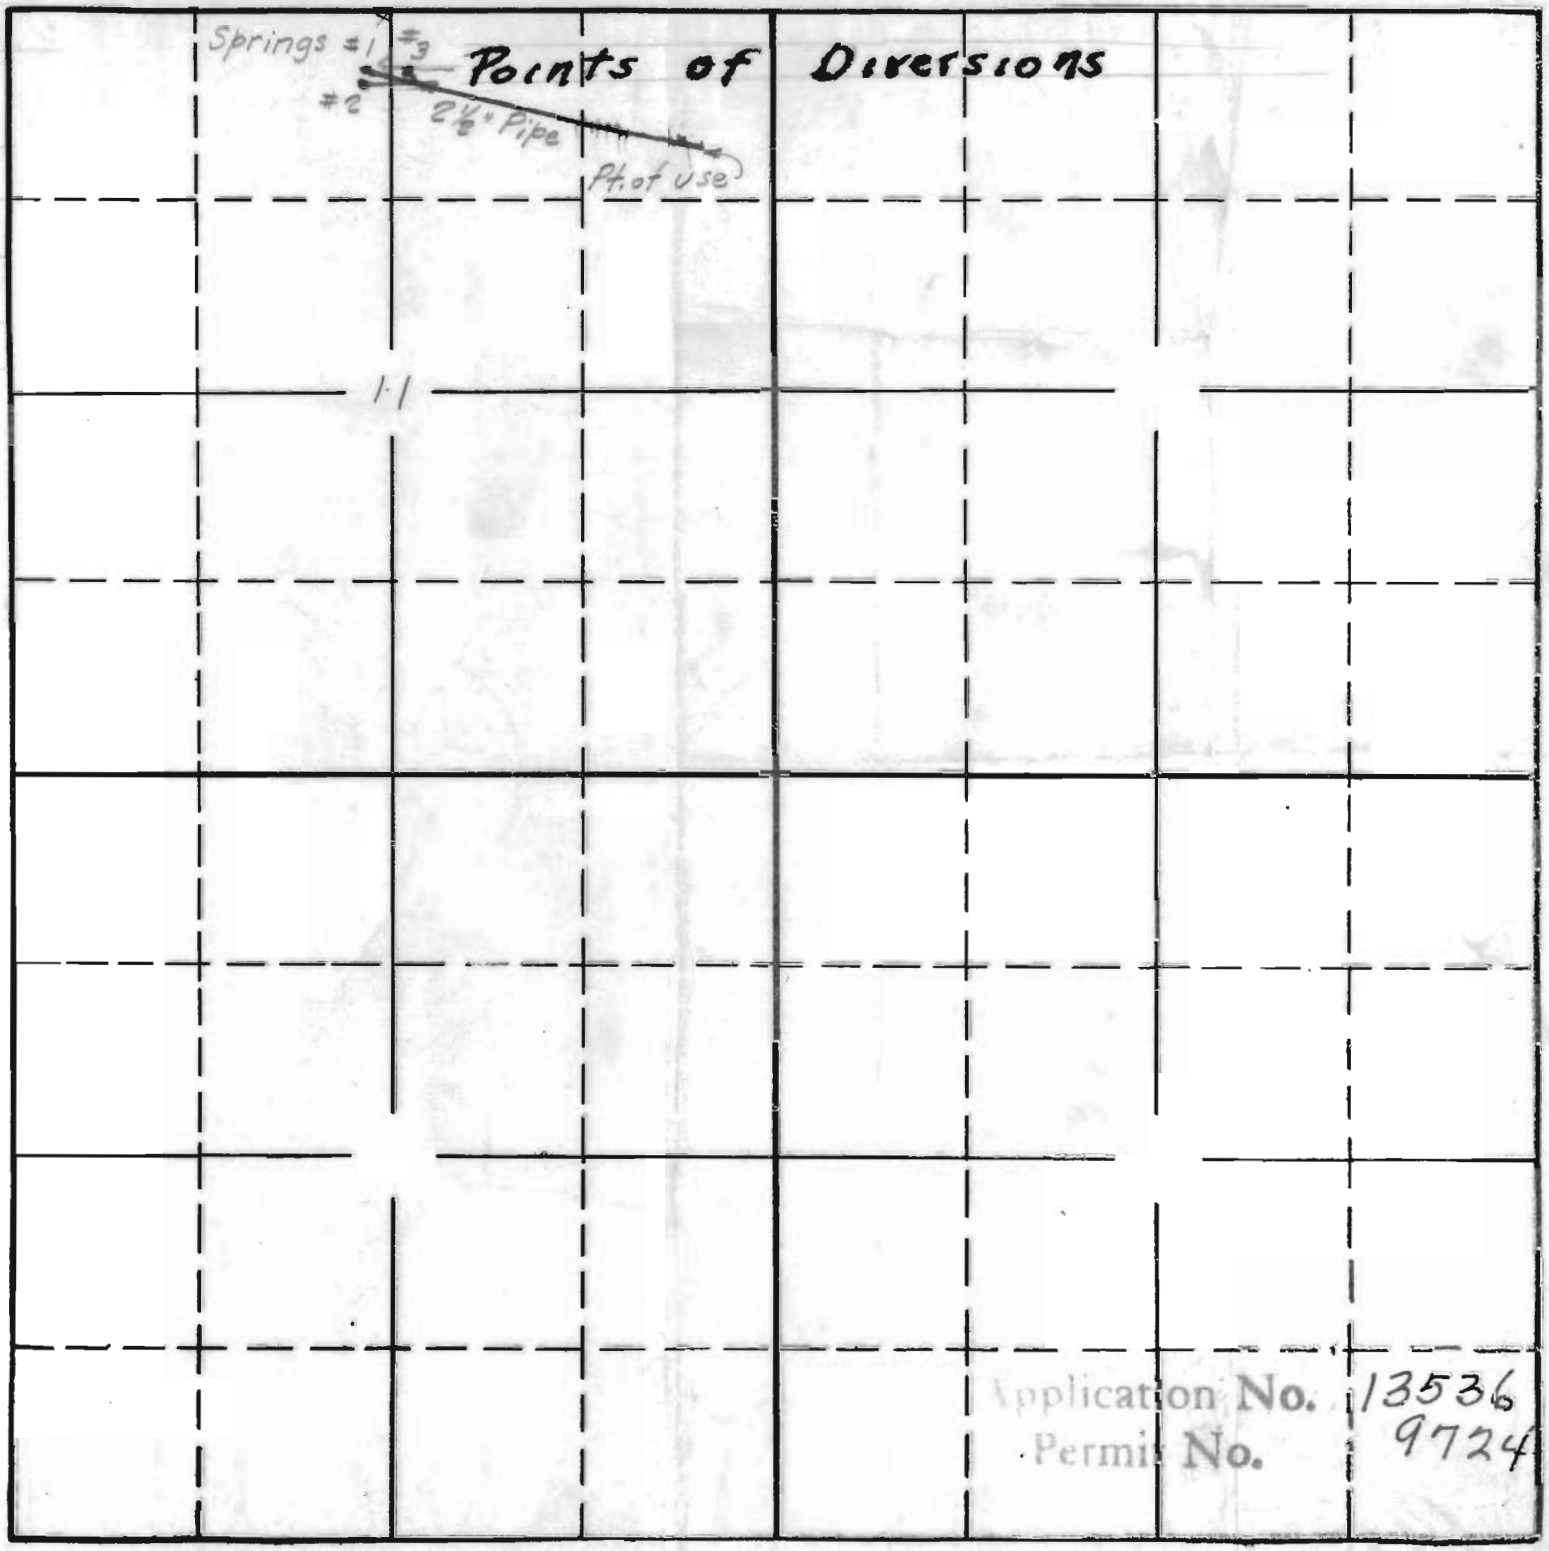

Sec. 11

Tp. 5N

R. 1W.