


Sec. 9

Tp. 25

R. 47E

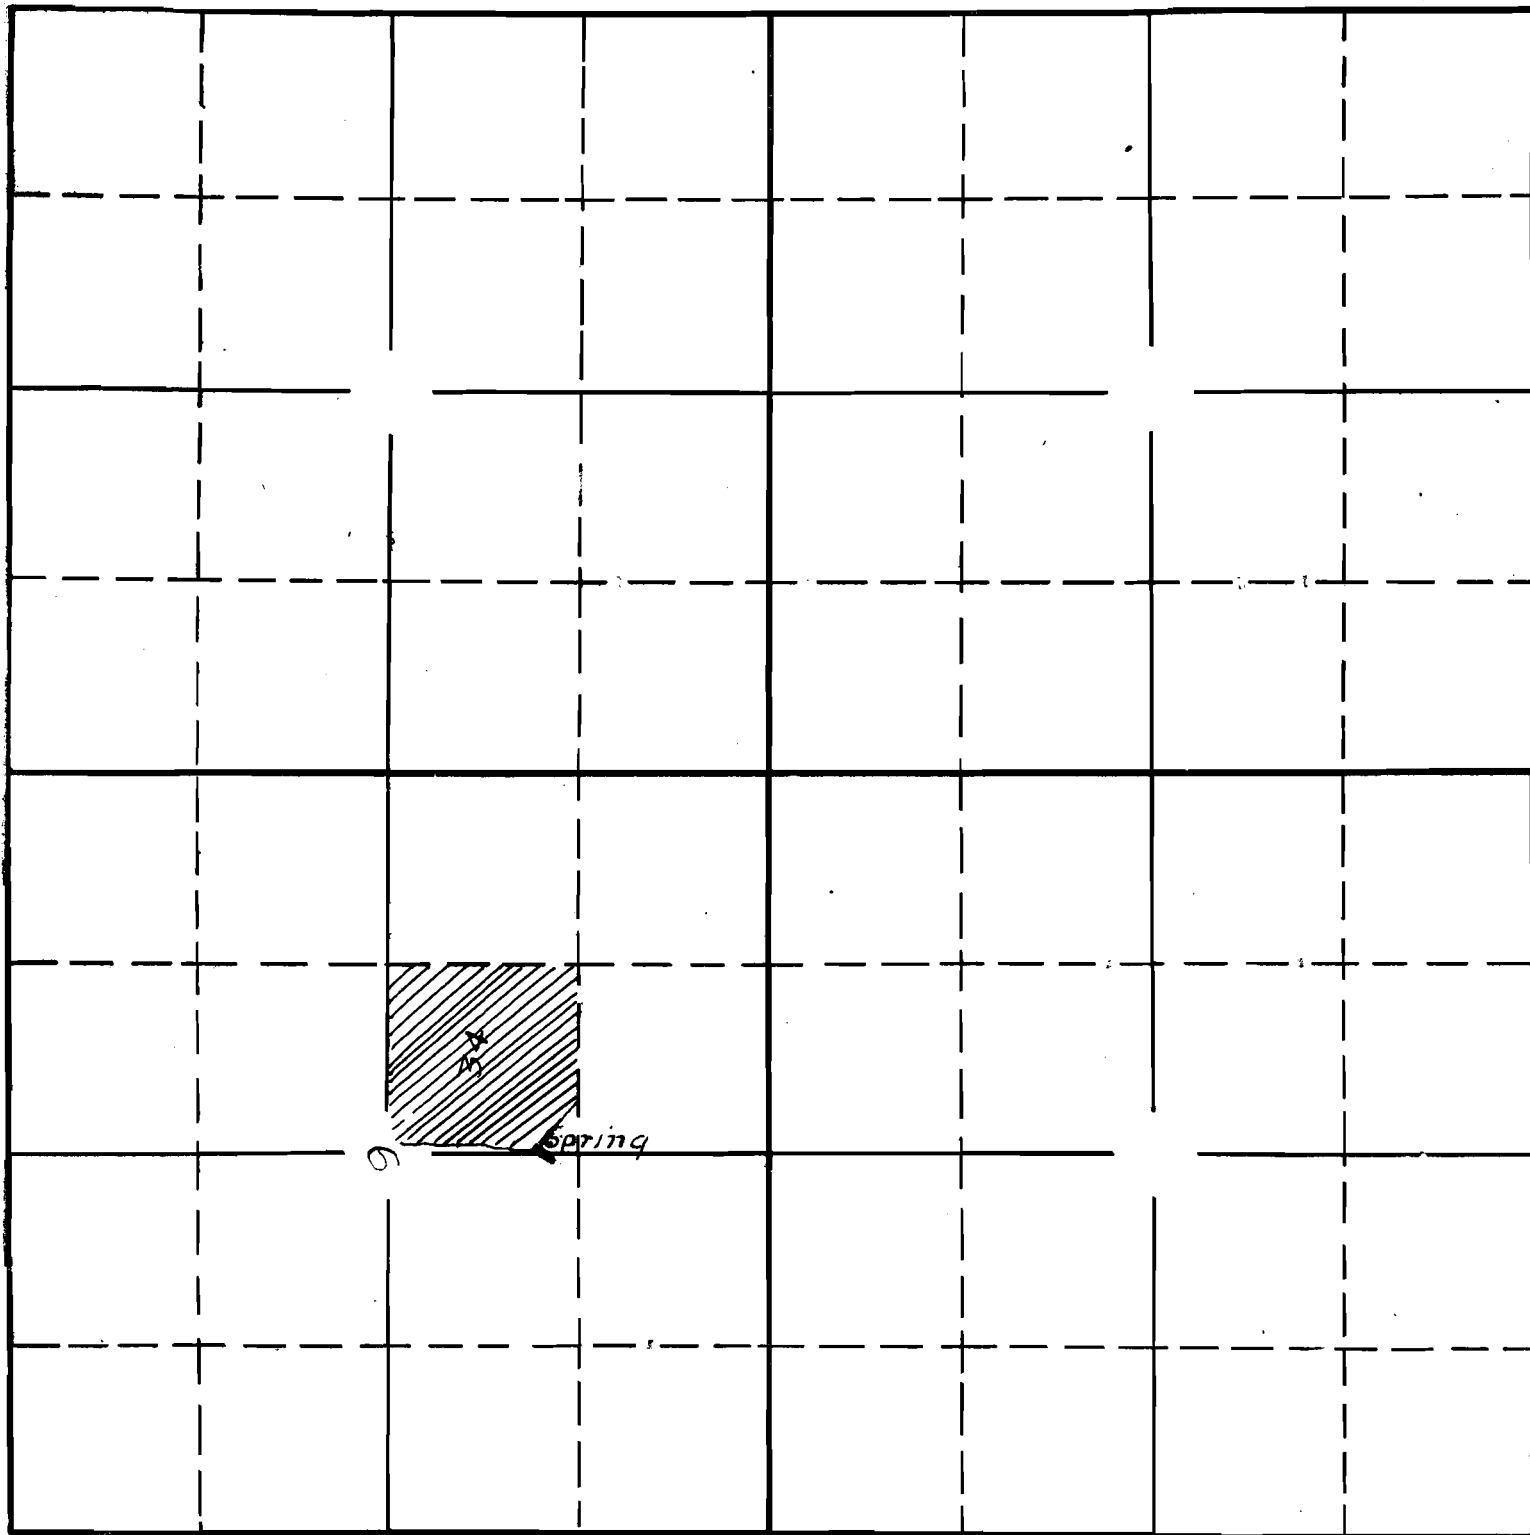

Application No. 13538  
Permit No. 9743