


SECTION

\_\_\_\_\_  
\_\_\_\_\_  
\_\_\_\_\_  
\_\_\_\_\_

TOWNSHIP 14S, RANGE 44E, W. M.

North

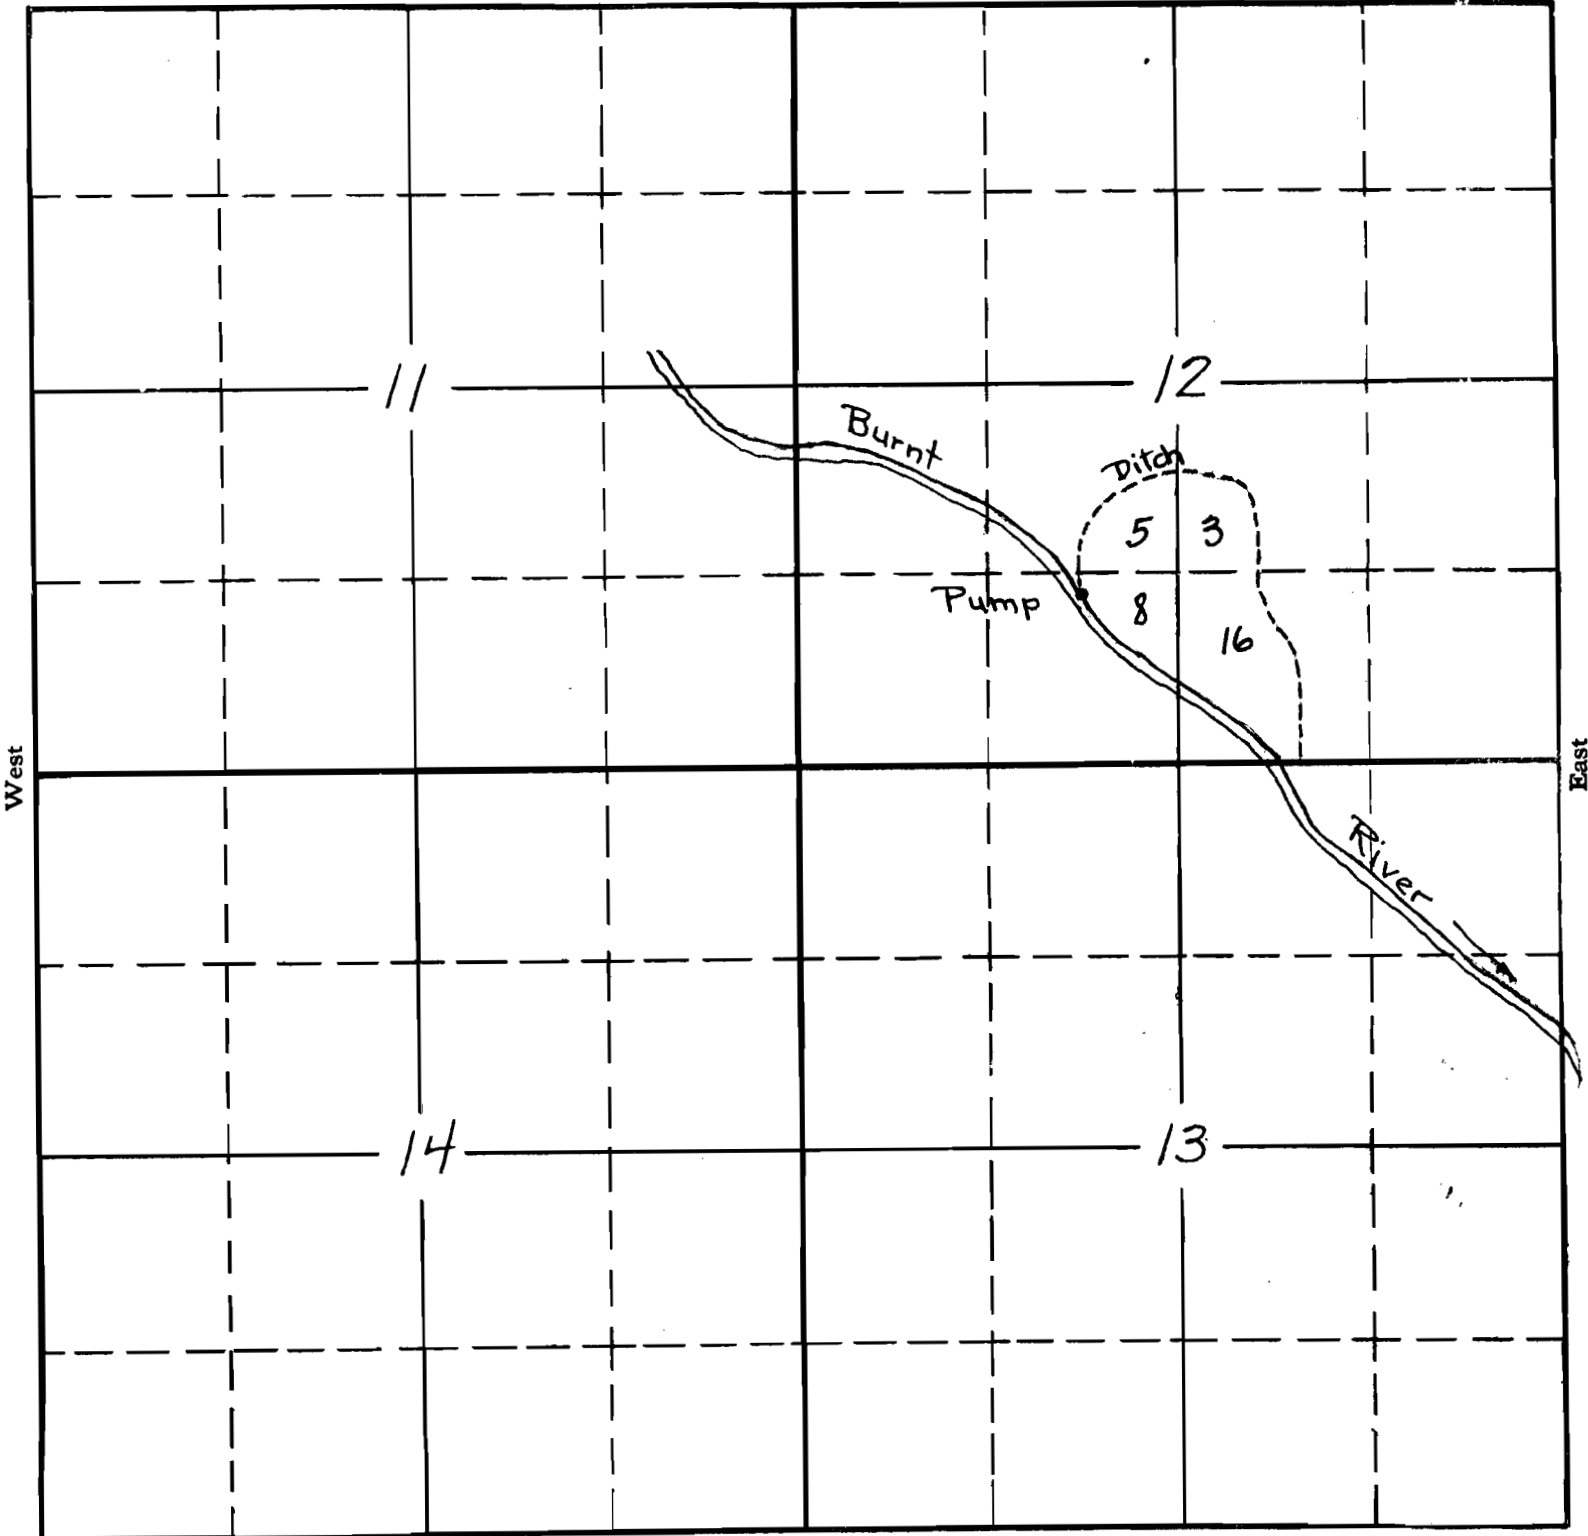

South

APPLICATION No. 13584  
PERMIT No. 9754