


MAP

to accompany Application for Water Right
on Unnamed Stream in Sec. 26 T. 25. R. 6 E. W. M.

Surveyed Aug. 1930 By U. Ernest Nelson.

Scale - 6" = 1 mile

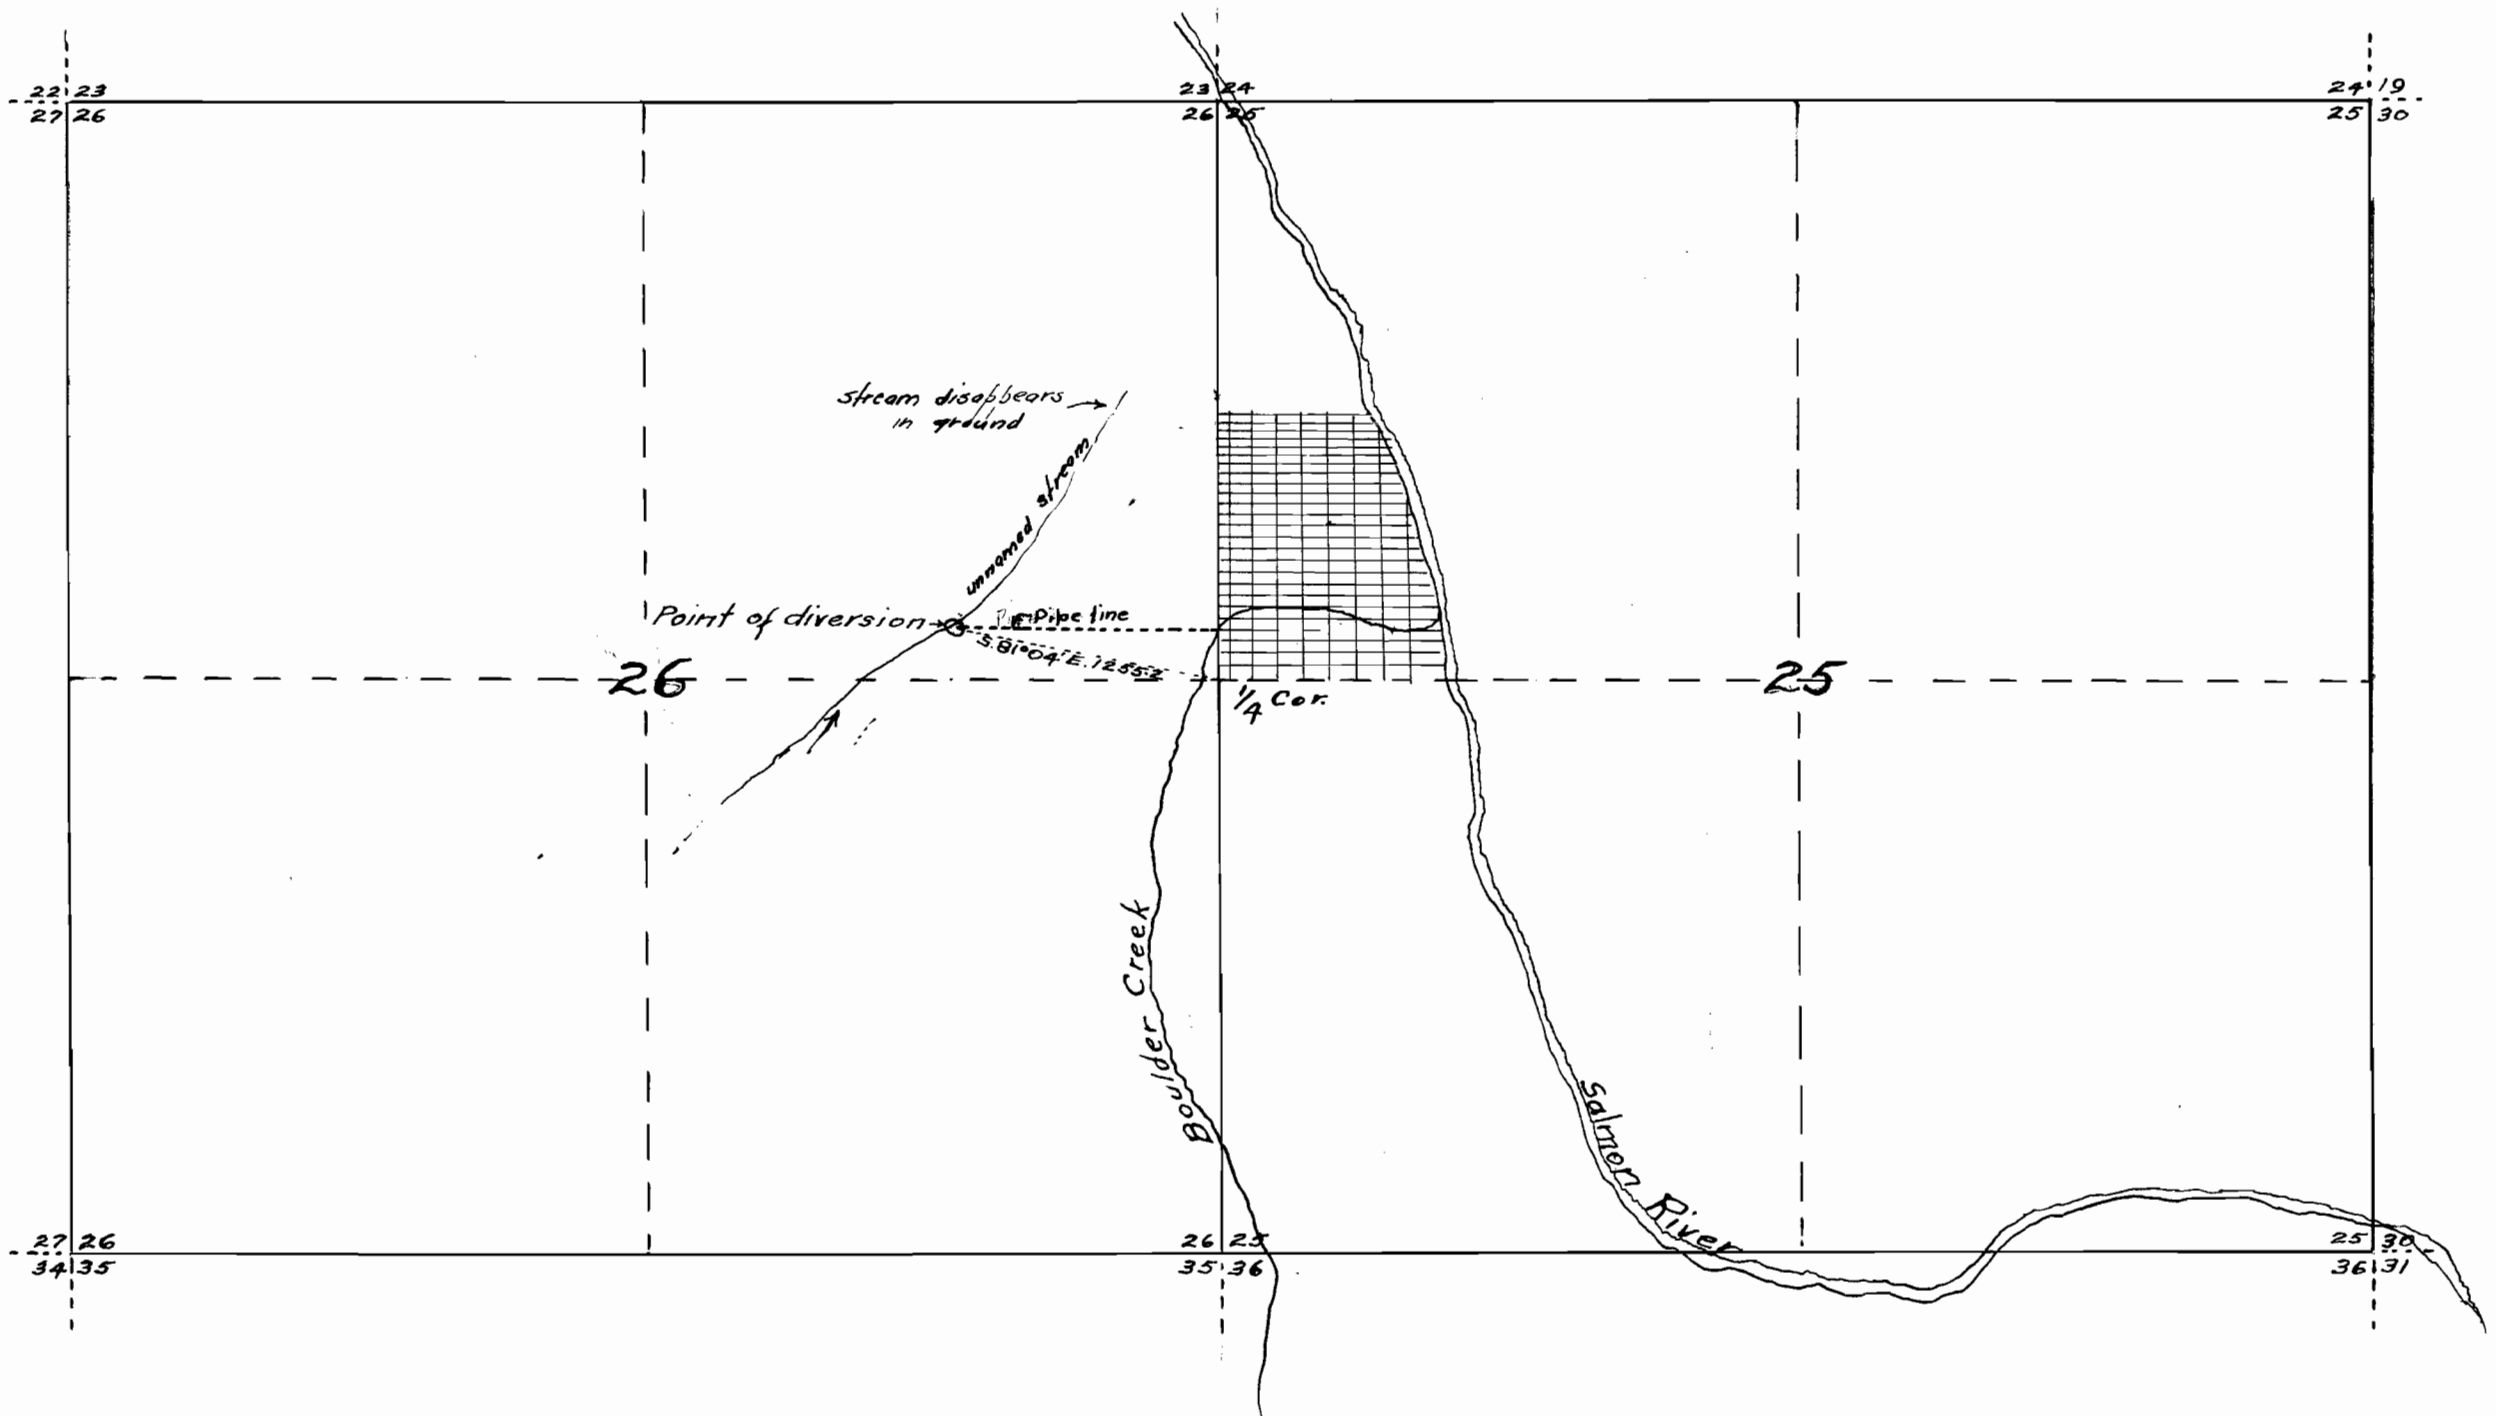

13597
9804