


SECTION

23

TOWNSHIP 6, RANGE 35 E, W. M.


North

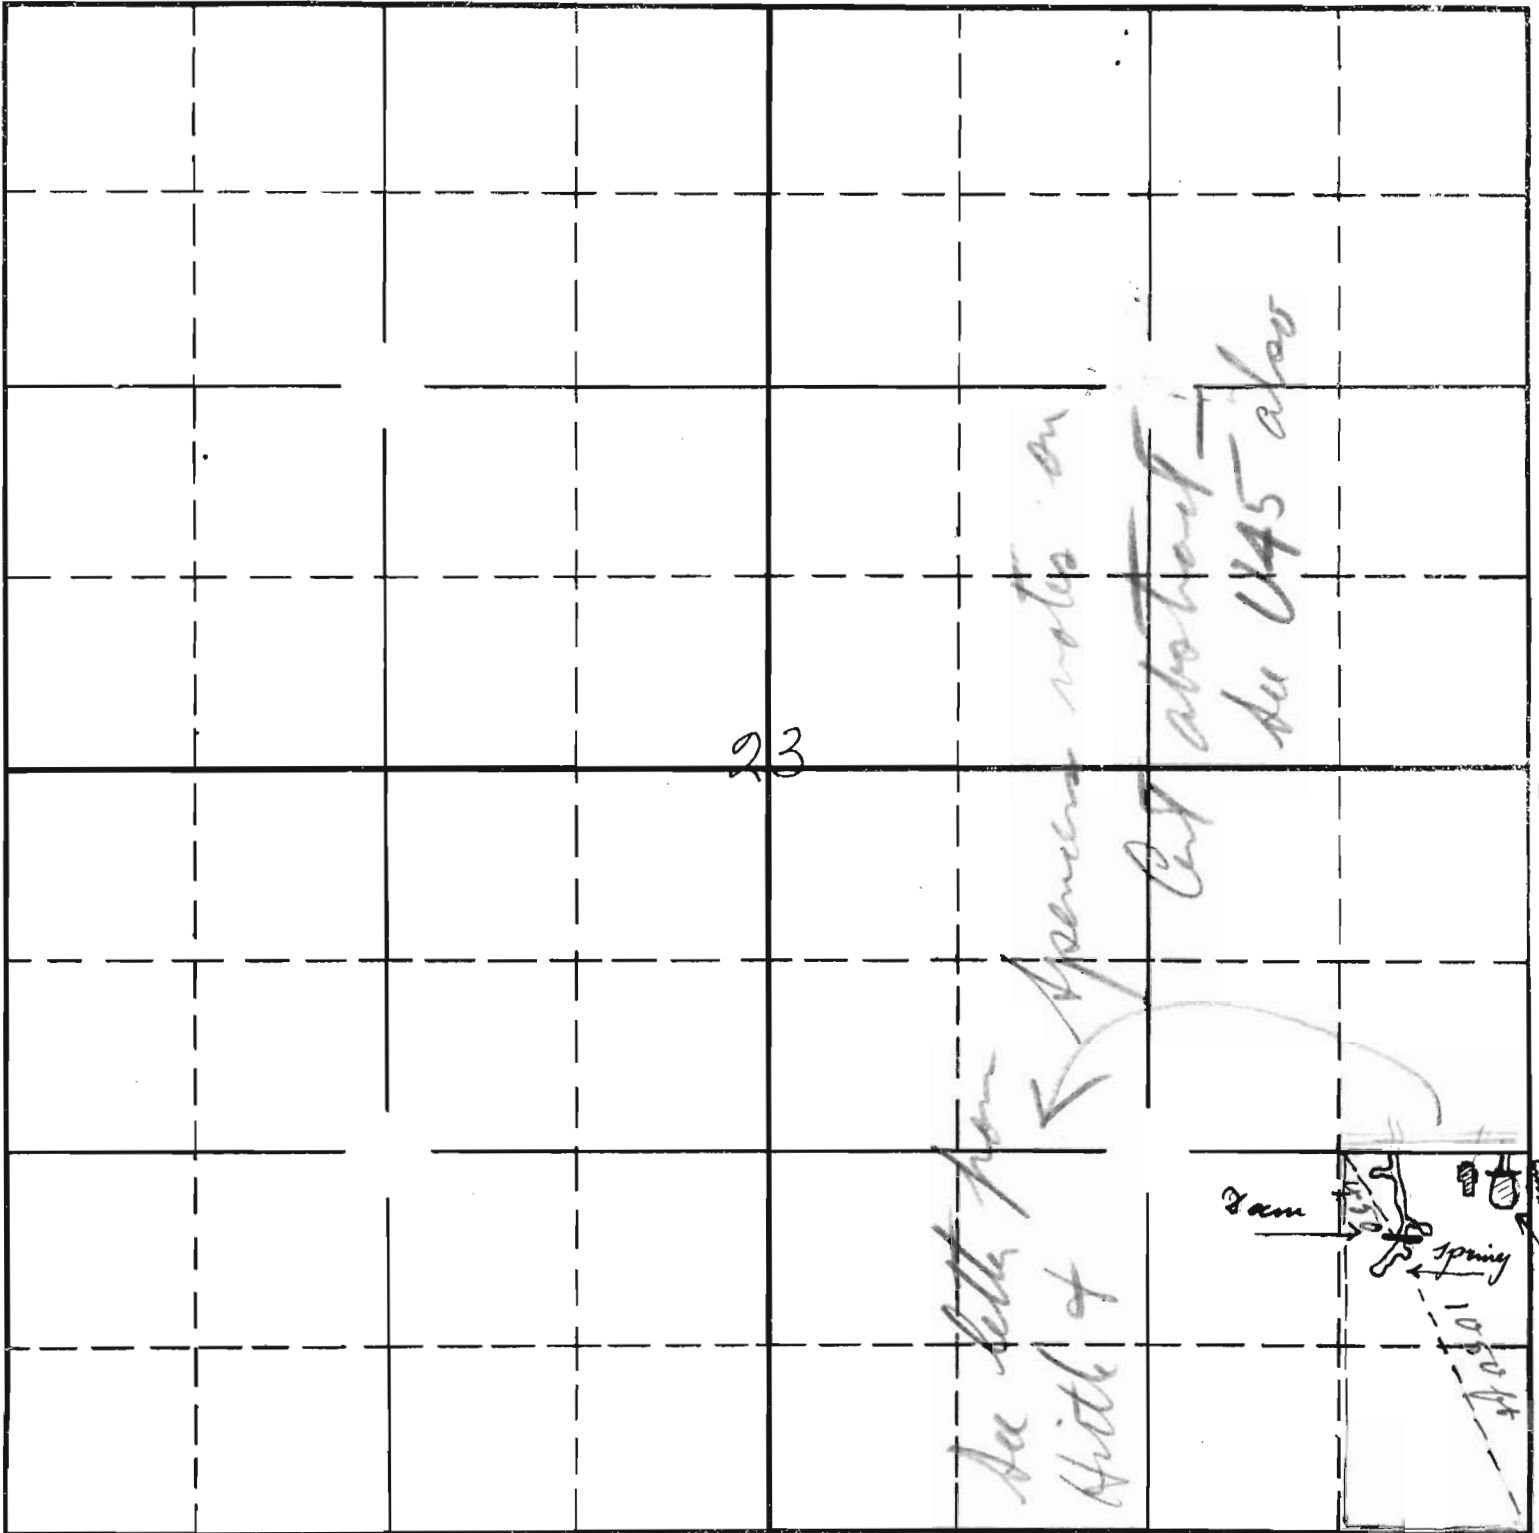

23

South

APPLICATION No. 13638
 PERMIT No. 9809

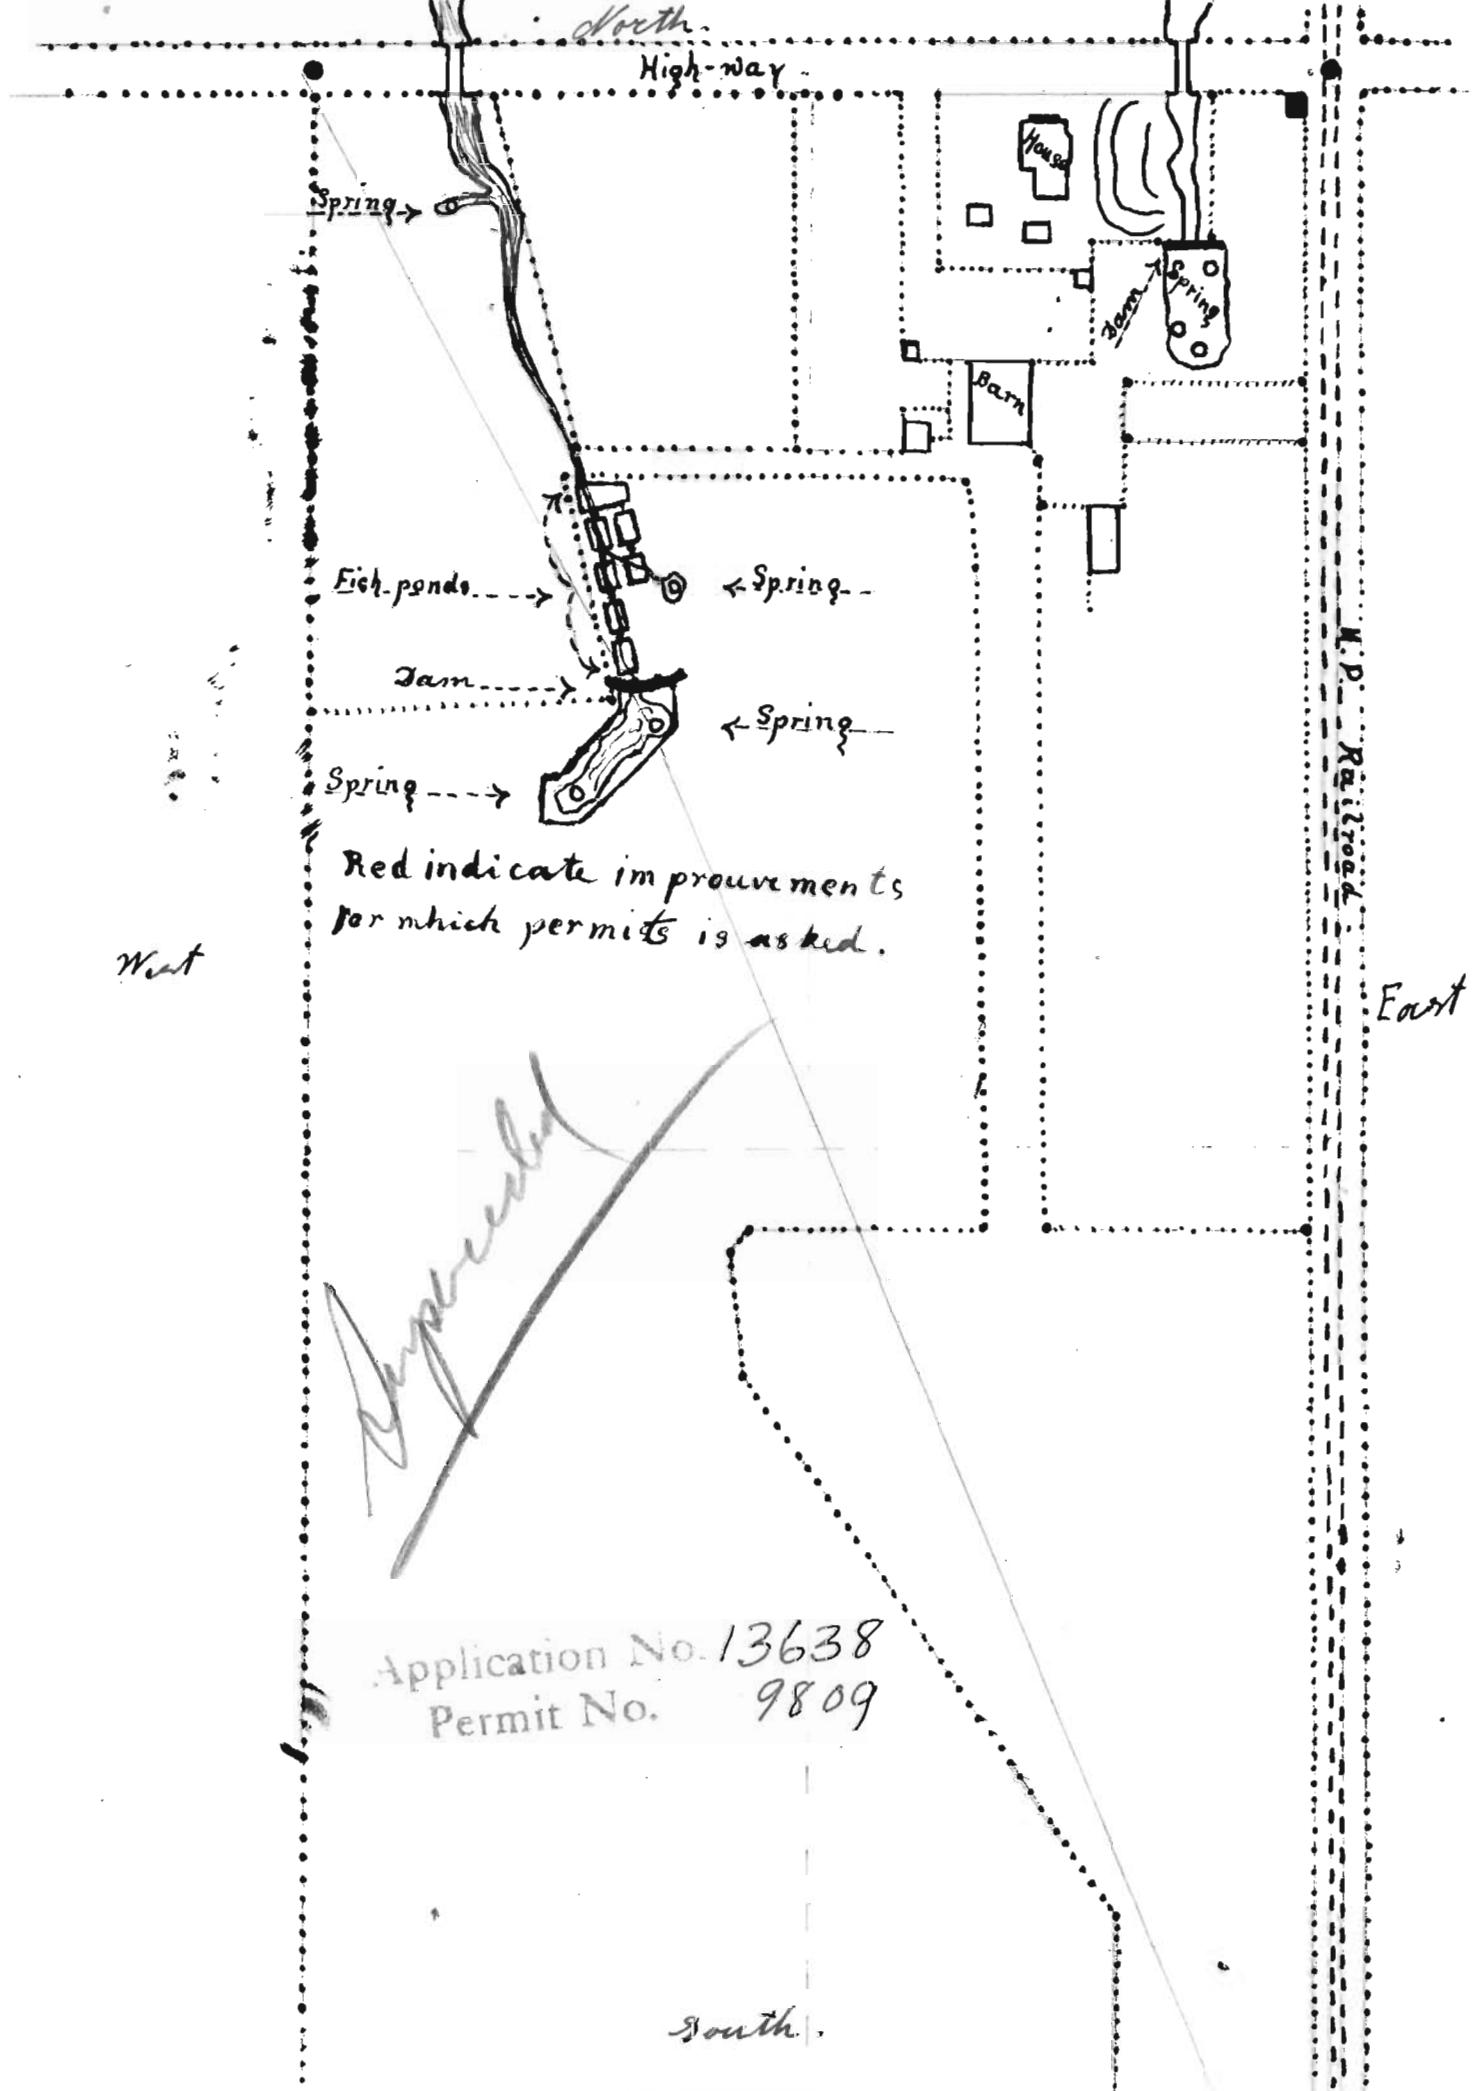

Red indicate improvements
for which permits is asked.

Application No. 13638
Permit No. 9809

South