


Sec. 31

Tp. 5-

R. 3 W. W.

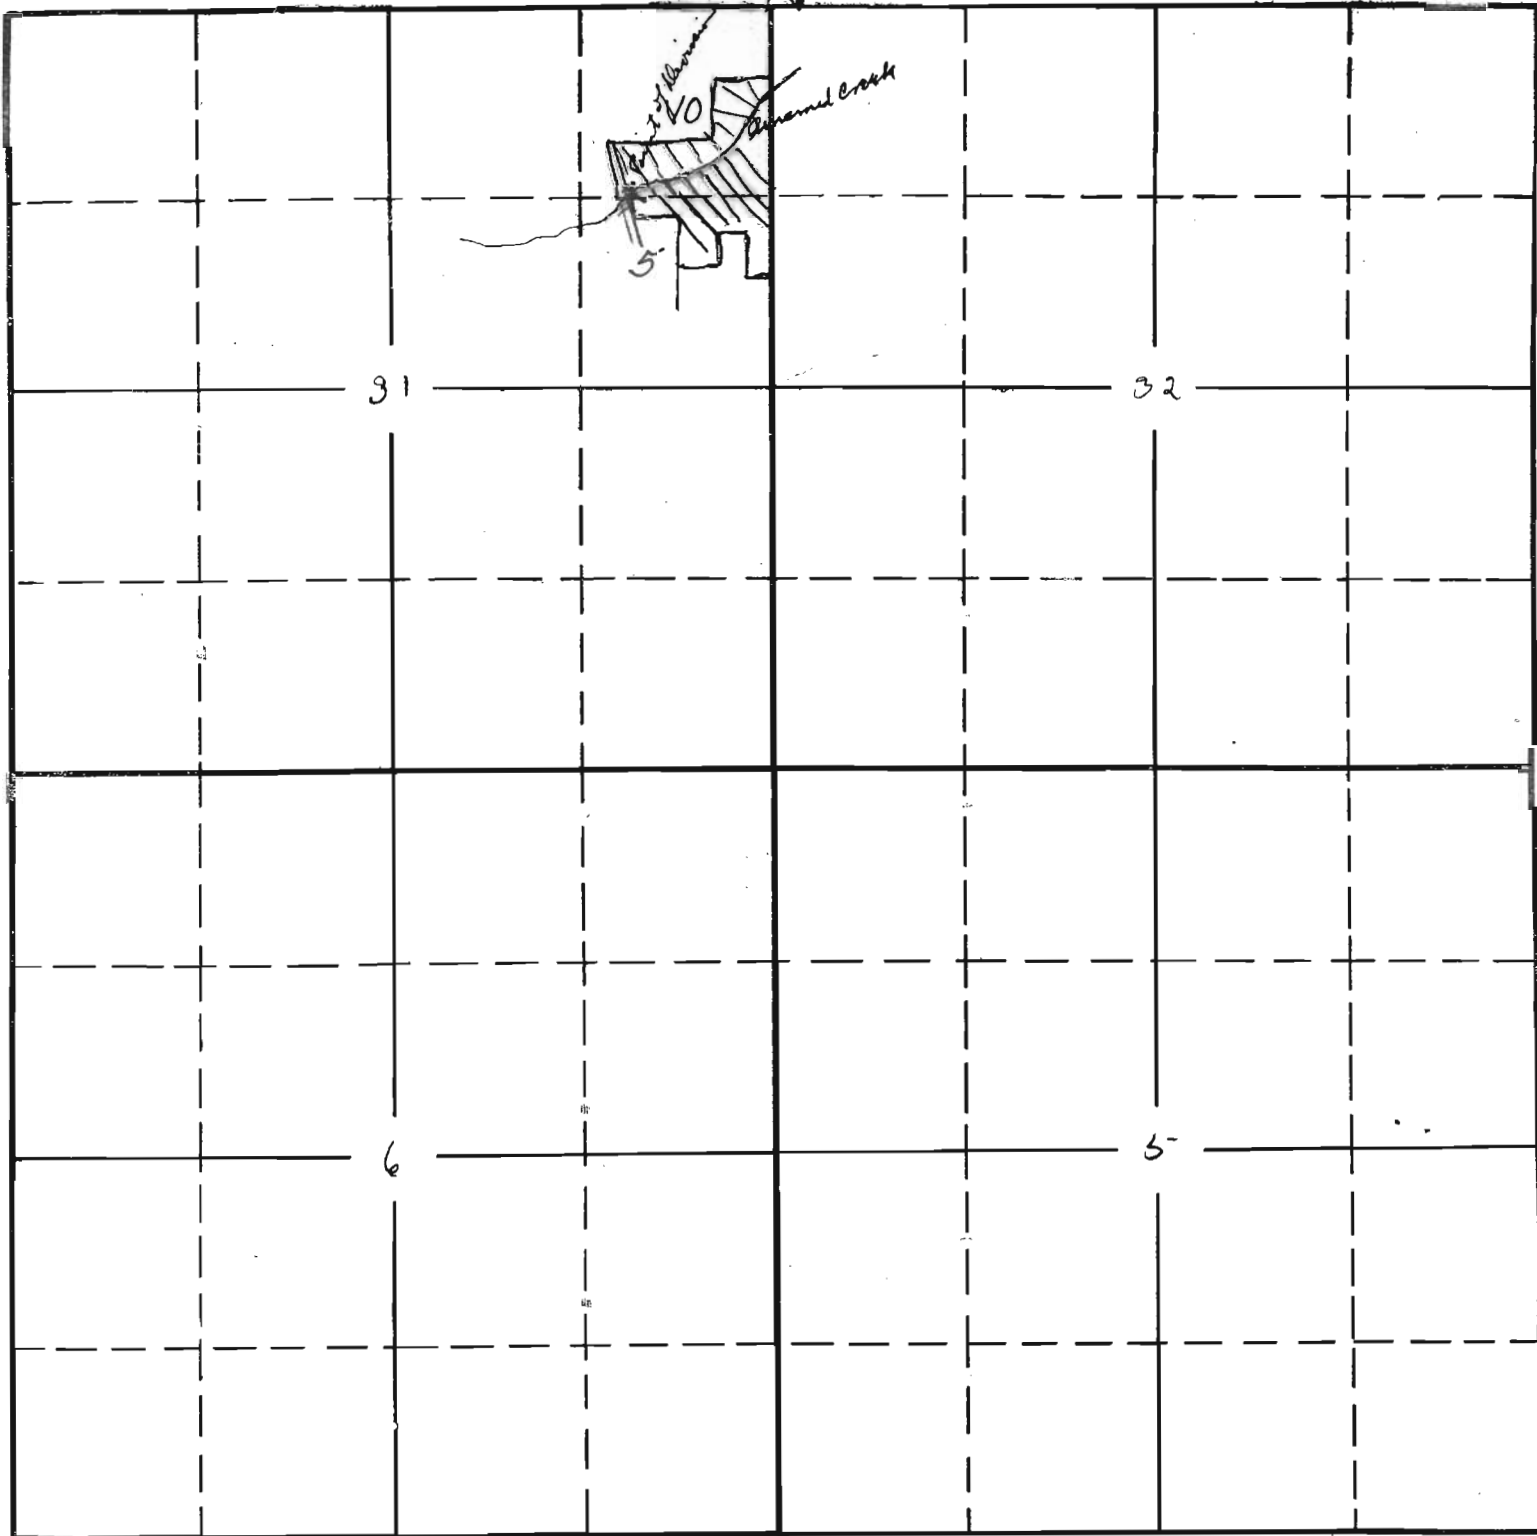

W

E

S

Application No. 13683
Permit No. 9830