


Application No. 13720  
Permit No. 9829

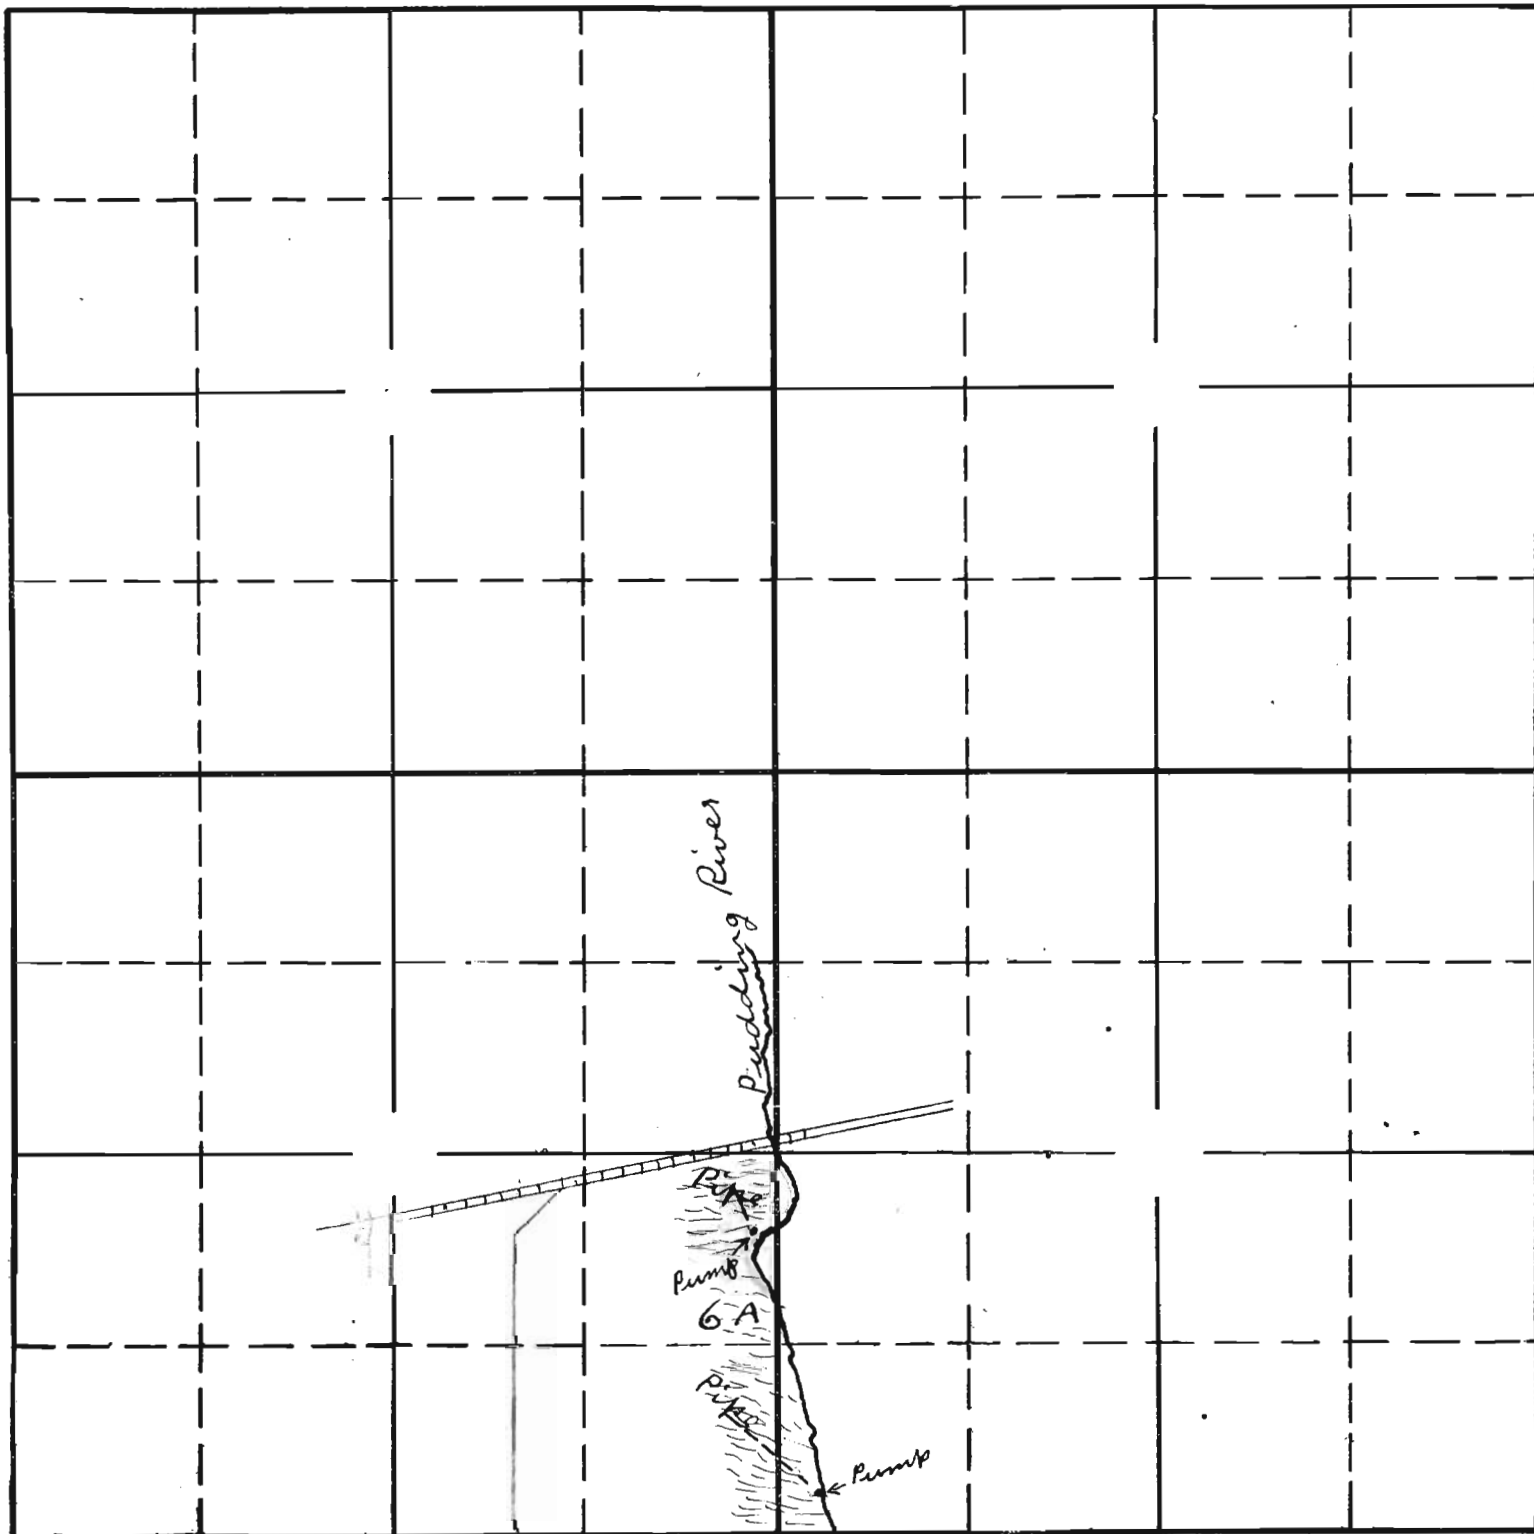

Sec. 5

Tp. 7 S

R. 1 W

County Road