


Sec. 33
SE 1/4

Tp. 33 S

R. 1 E

N

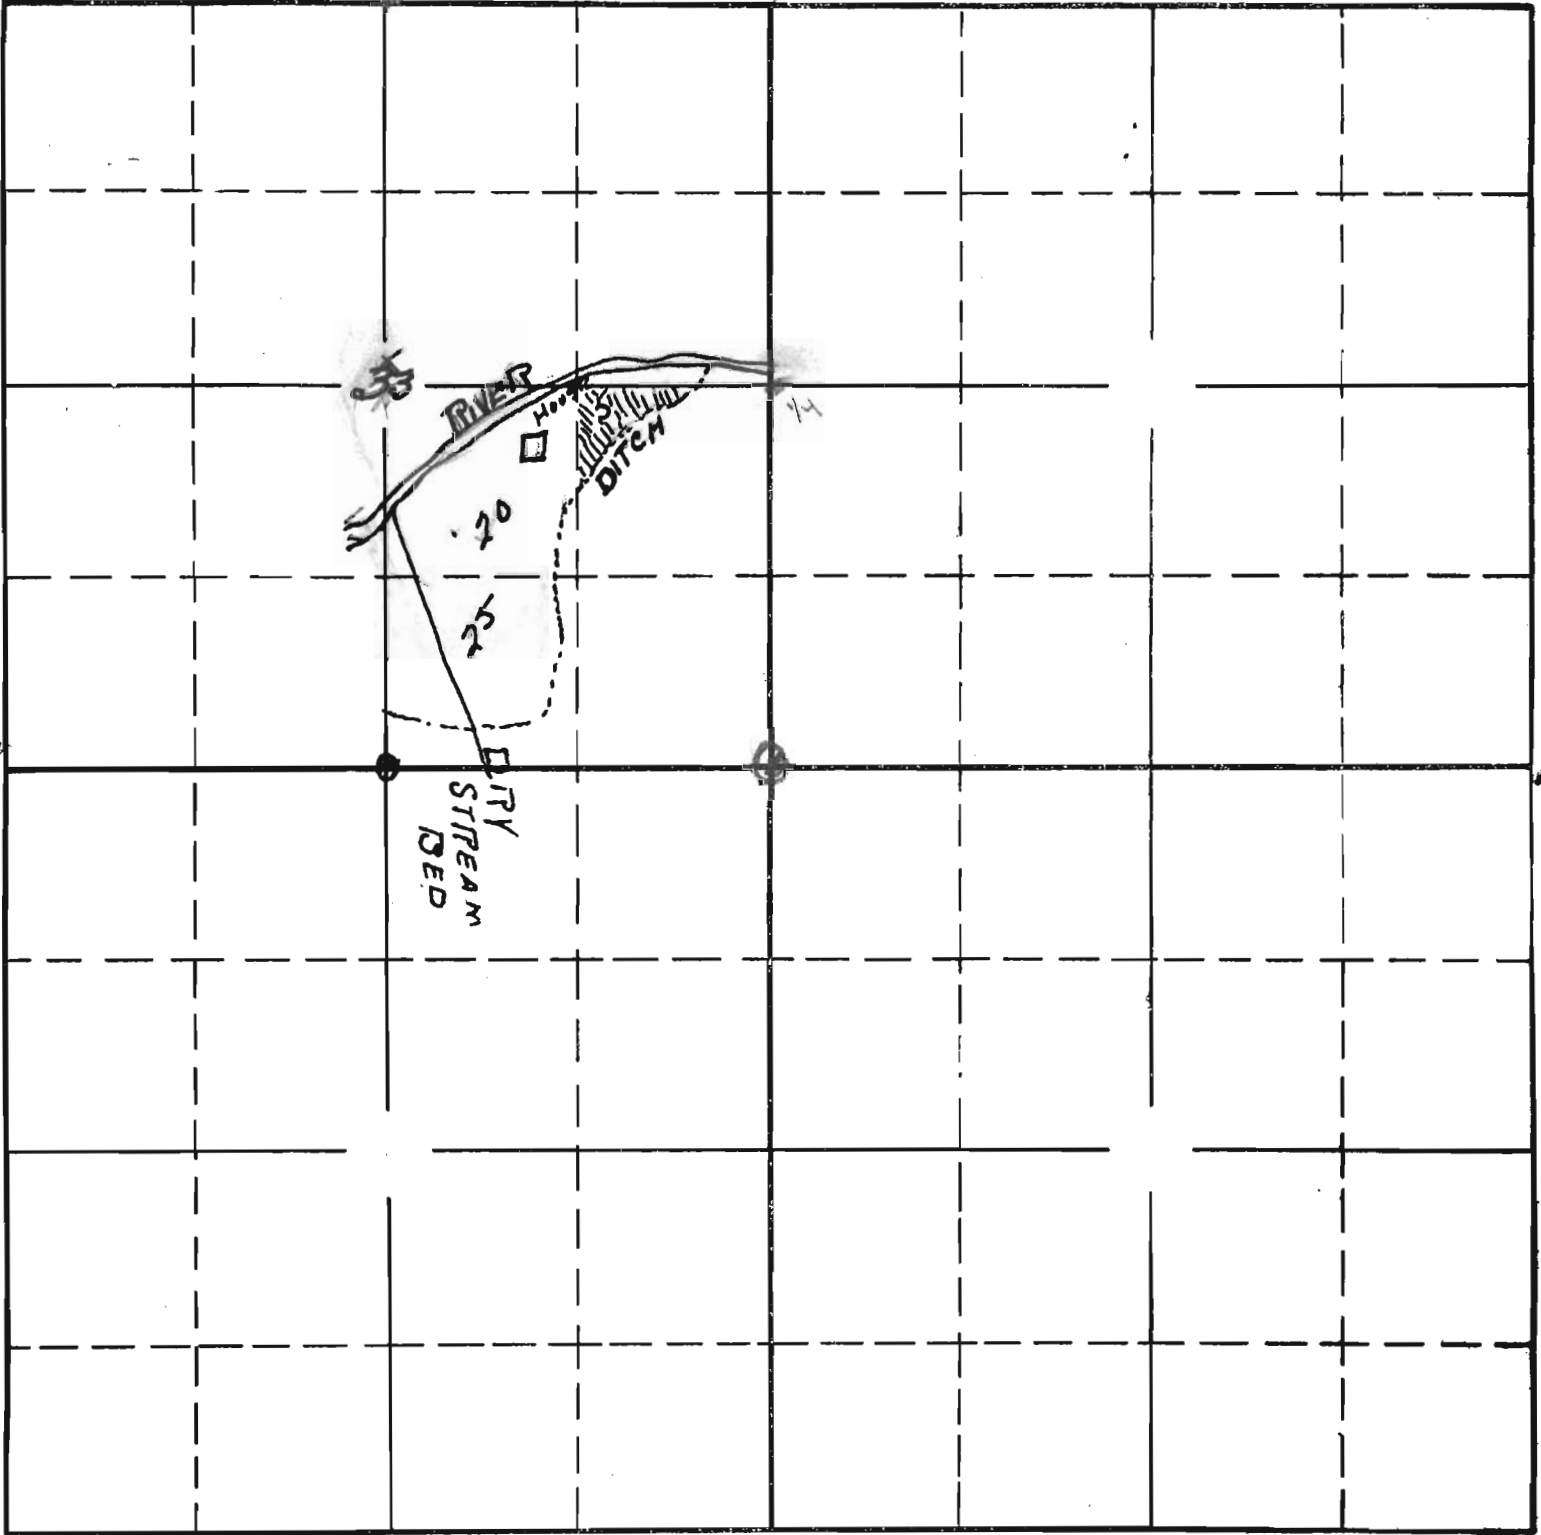

S

Application No. 13635
Permit No. 9834