


SECTION

TOWNSHIP 2N, RANGE 10W, W. M.

North

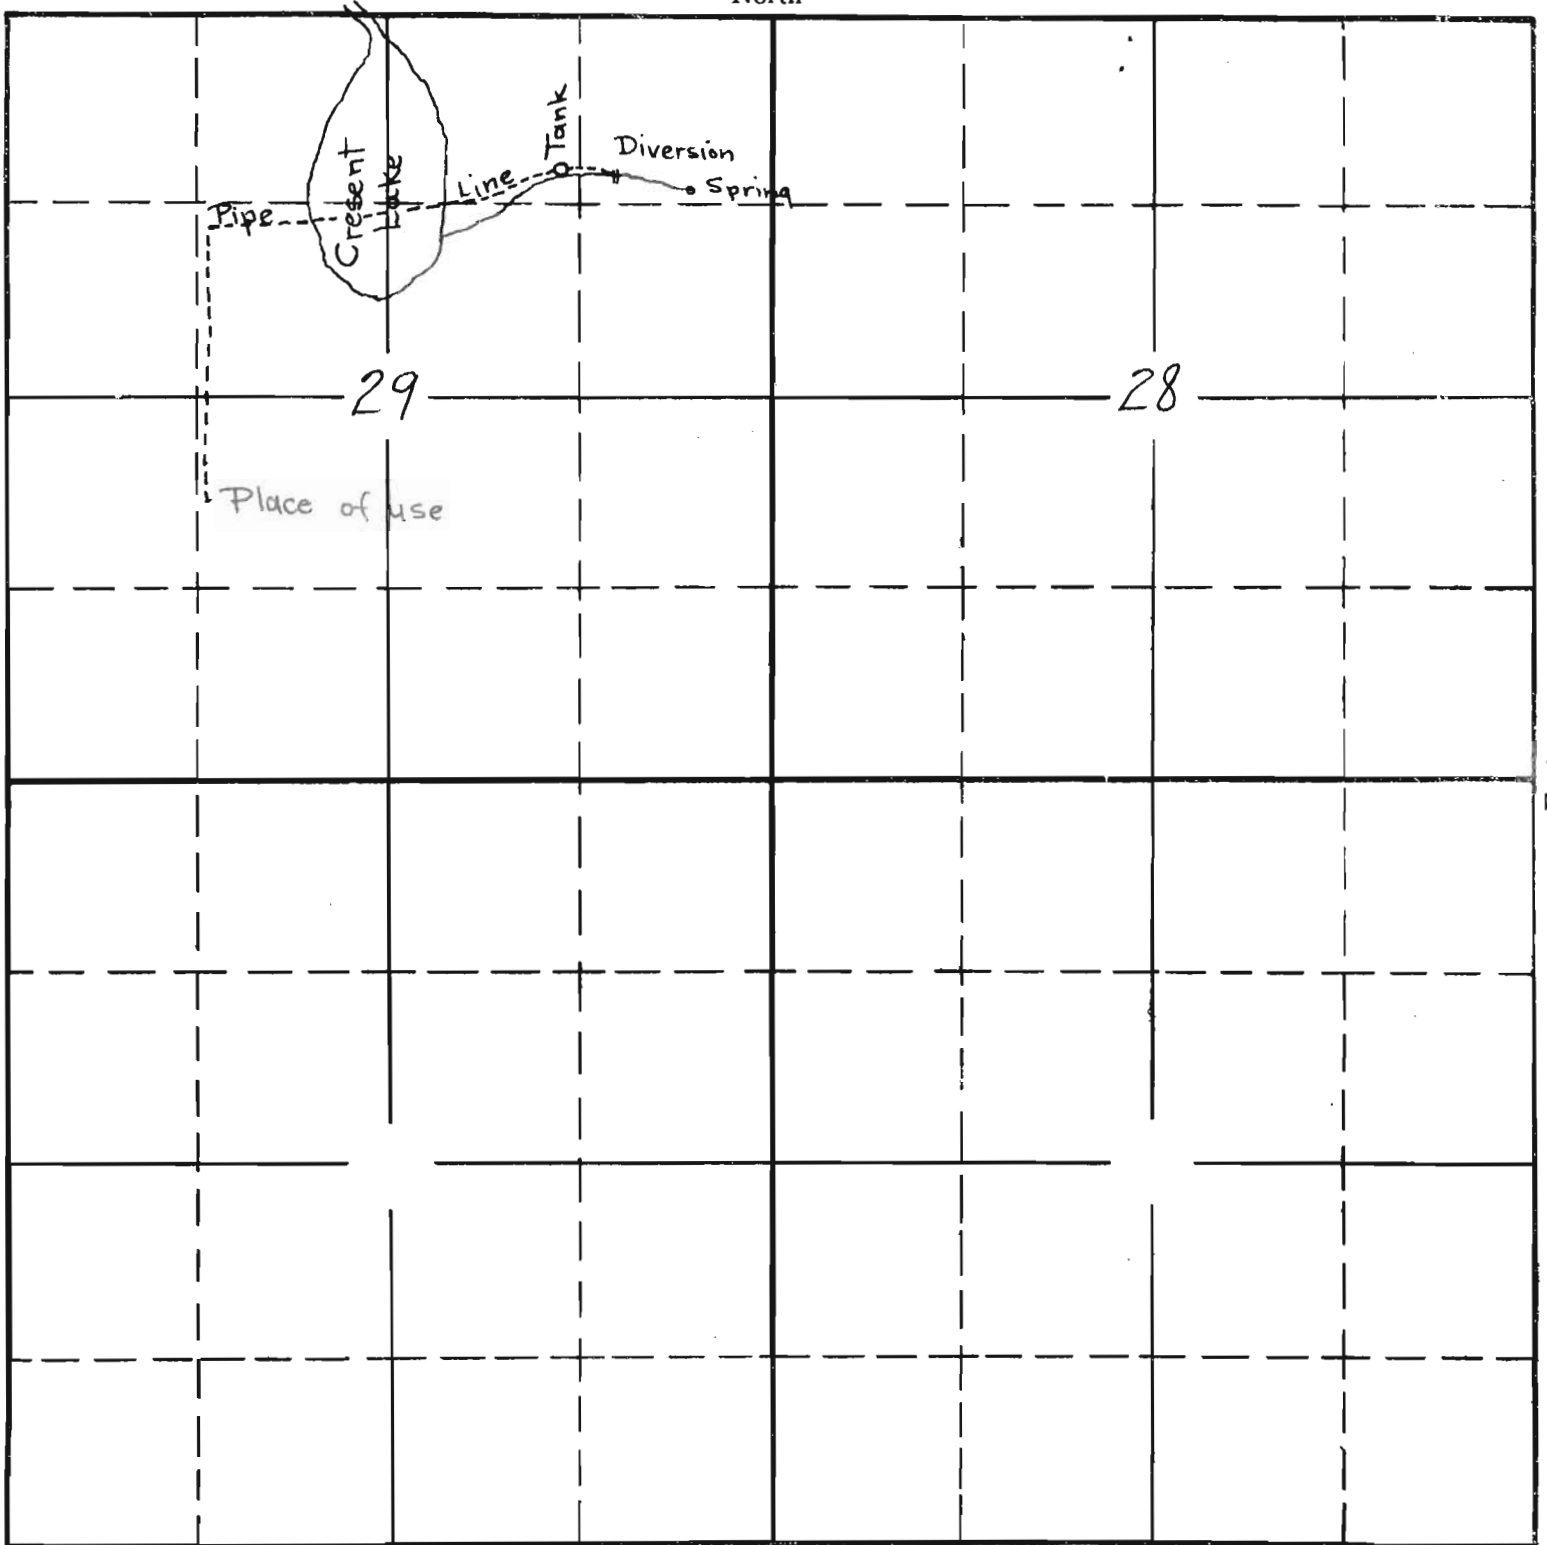

South

APPLICATION No. 13687
PERMIT No. 9839