


SURVEYOR'S CERTIFICATE
 I, W.F. Anderson, County Surveyor of Tillamook, Ore do hereby
 certify that this map was made from notes taken during an
 actual survey made by me in Aug. 1930, and that it correctly
 represents the location of Streams and pipe Lines.

County Surveyor
W.F. Anderson

BEELS ADD TO LAKELYTLE

N.W. Corner of the N.E. 1/4 of
 the S.E. 1/4 of Section 32 T.
 2 N. R. 10. W. W. 11.

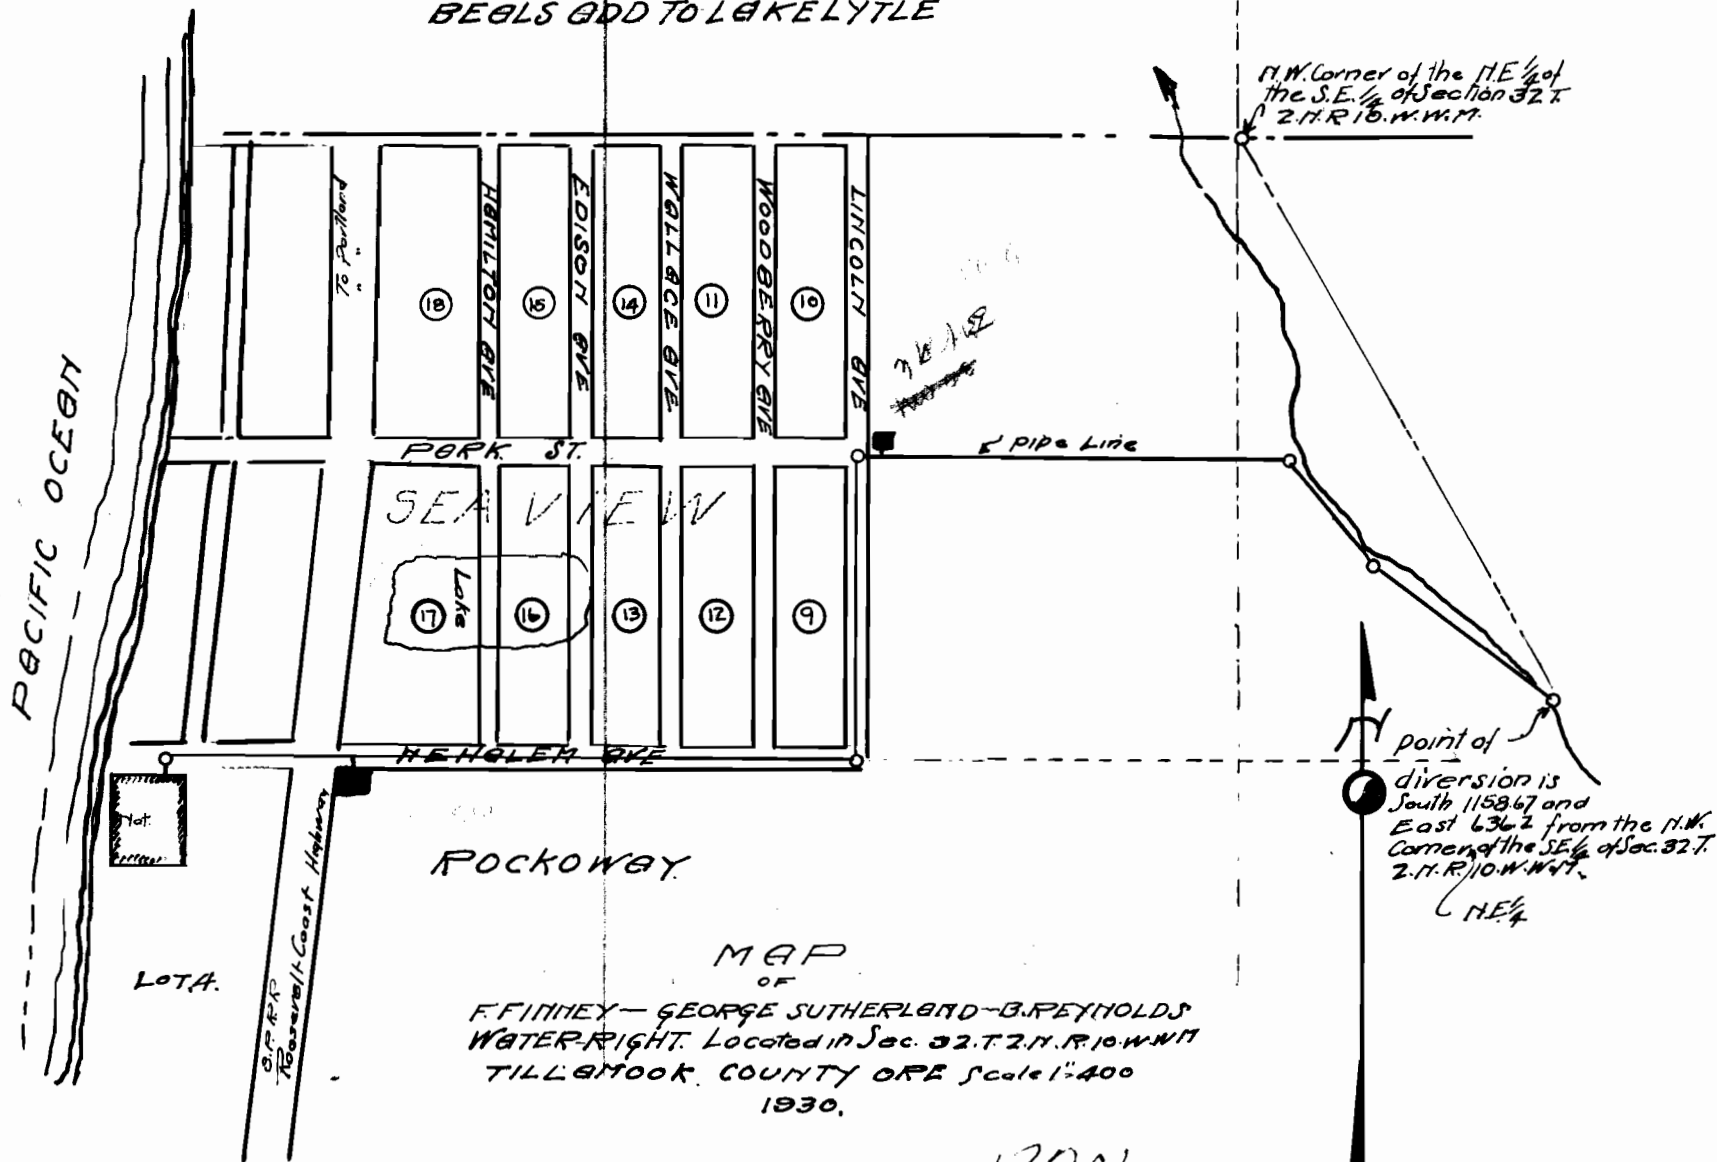

Application No. 13701
 Permit No. 9842