


SECTION
29
S. W. 1/4
of S. E. 1/4

Permit: S 9880
Volume: 7
Strm: A SPR
Trib: GRAYS CR
Priority: 9/15/30

TOWNSHIP 37 S, RANGE 5 W

37-5-29

North

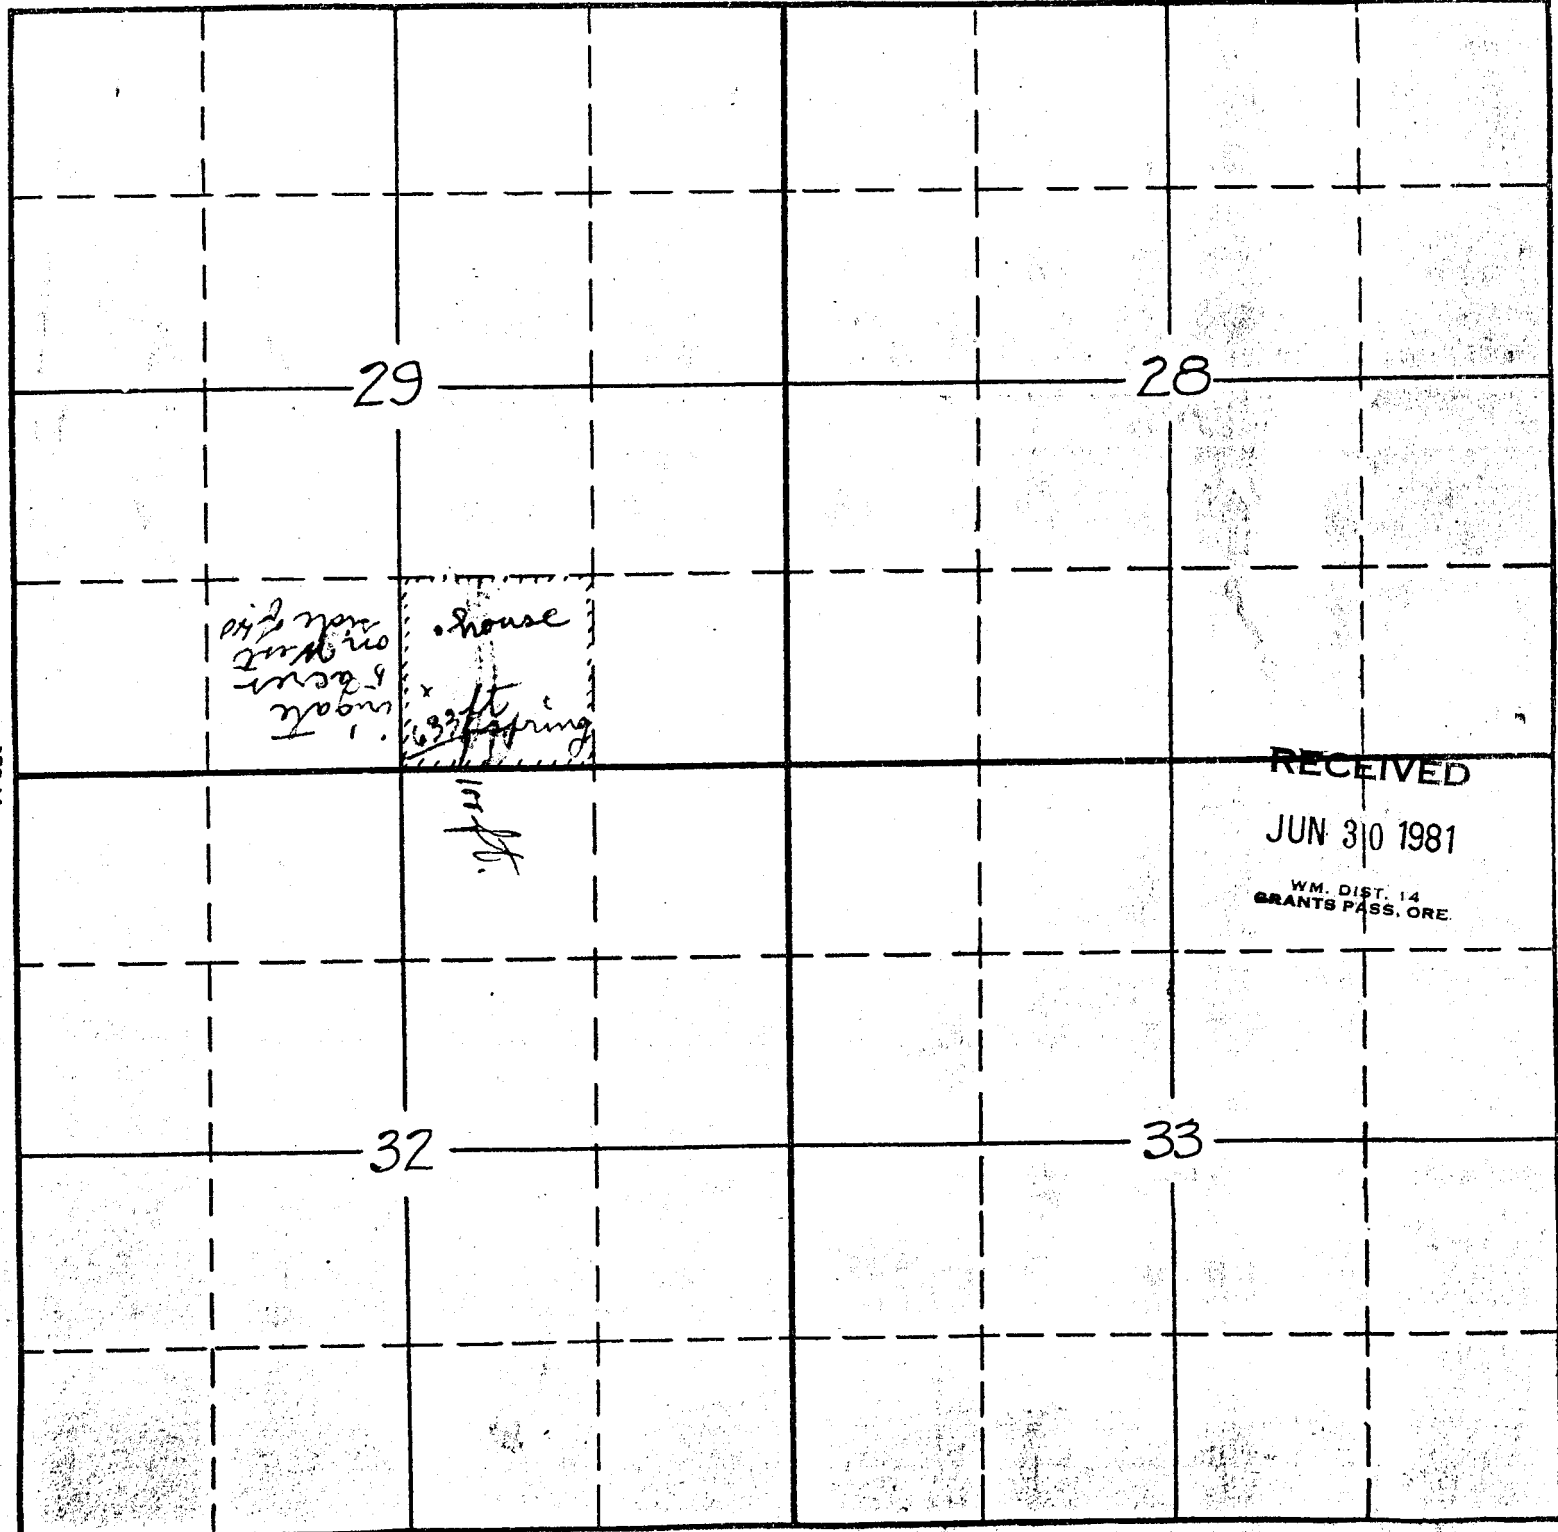

South

APPLICATION No. 13731
PERMIT No. 9880