

SECTION


TOWNSHIP 75, RANGE 11W, W. M.

*Penny*

North

West

East

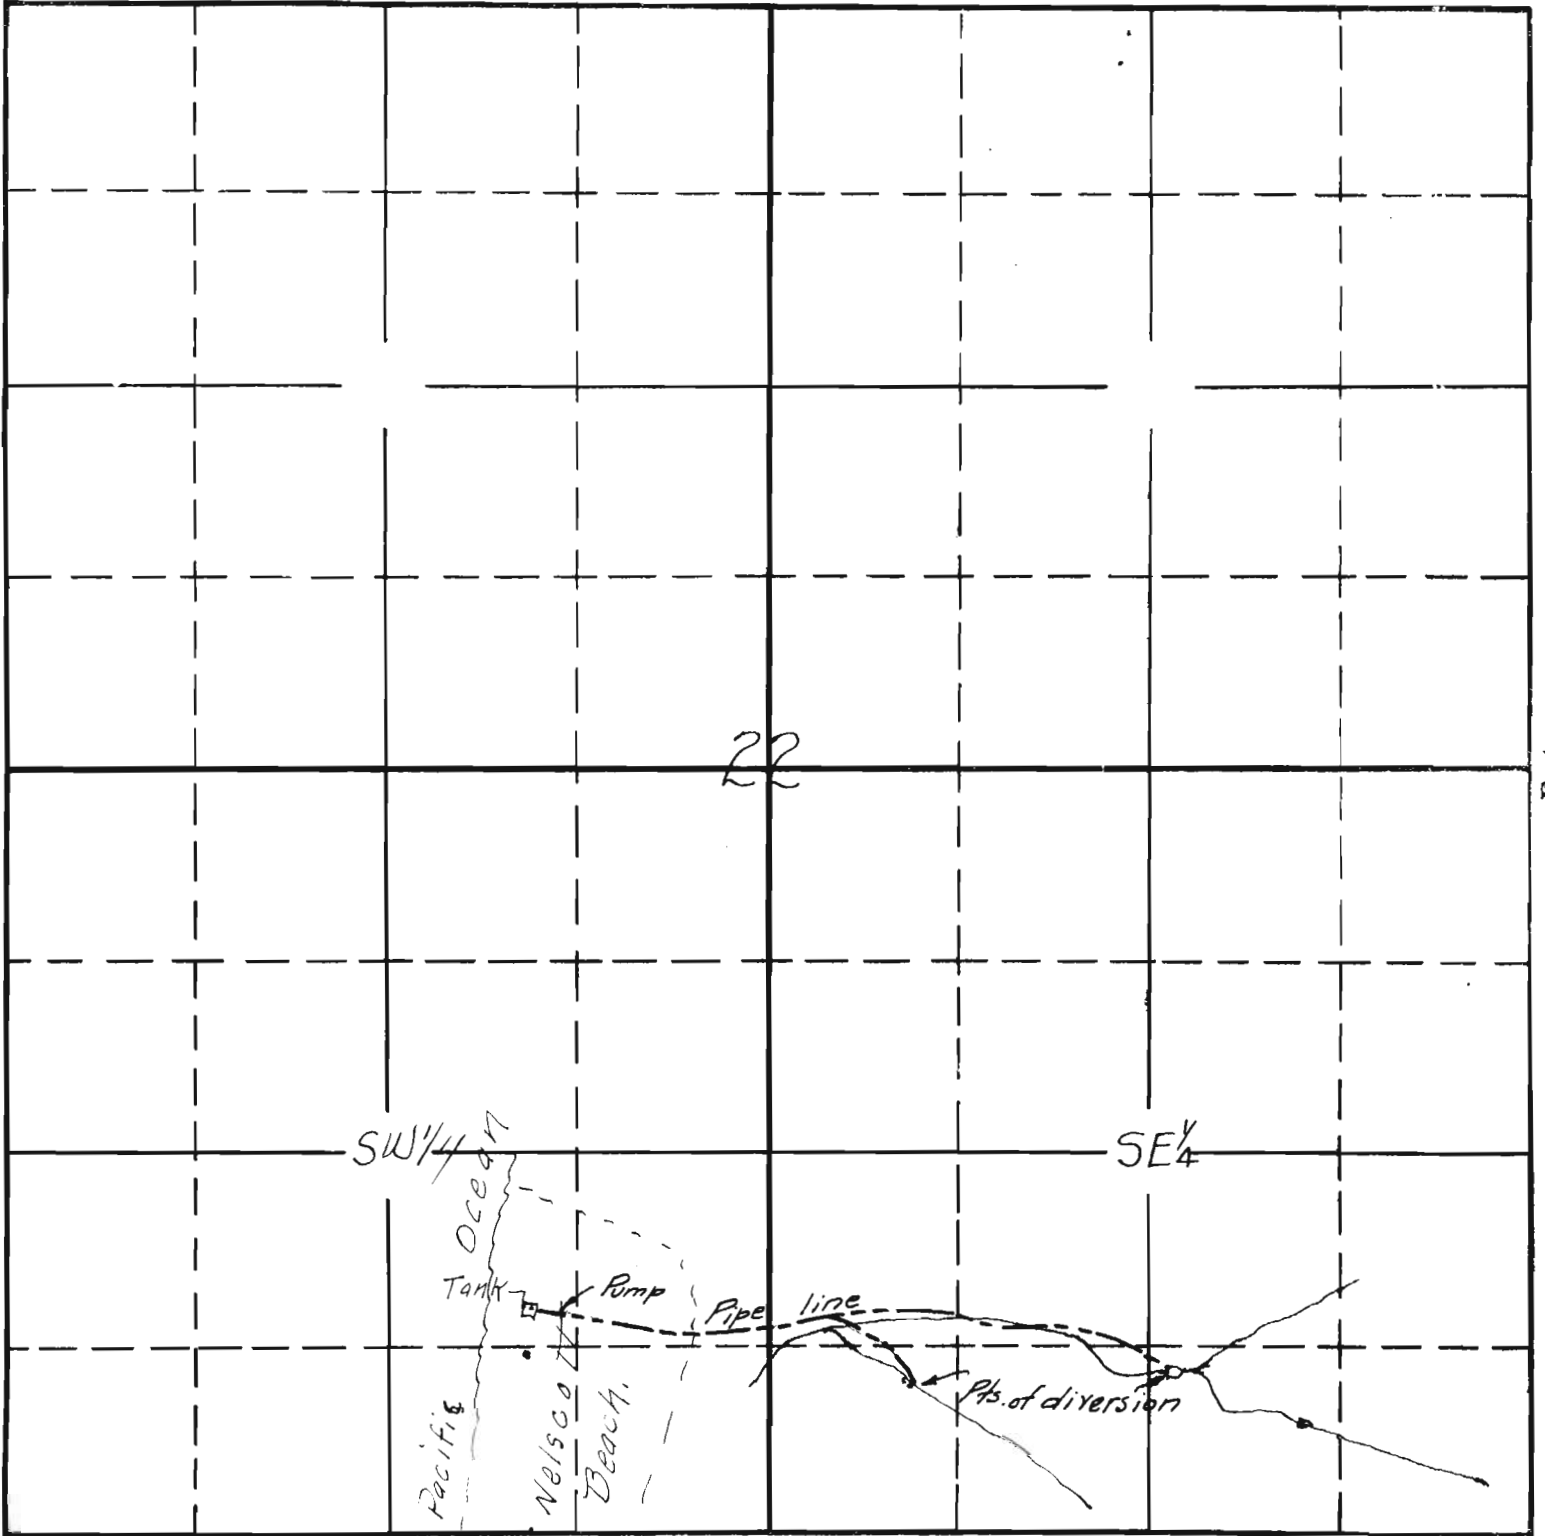

South

APPLICATION No. 13750  
PERMIT No. 9887



PACIFIC OCEAN



# VEL SCOTT BEACH

SURVEYED BY M. L. HARSHBECER  
SCALE 1 IN. = 100 FT.

13750  
9887