

SECTION

15

TOWNSHIP 37 S RANGE 6 W

Permit: S 9889


Volume: 6A

Strm: UNN SPRS

Trib: APPLEGATE R

Priority: 9/26/30

North

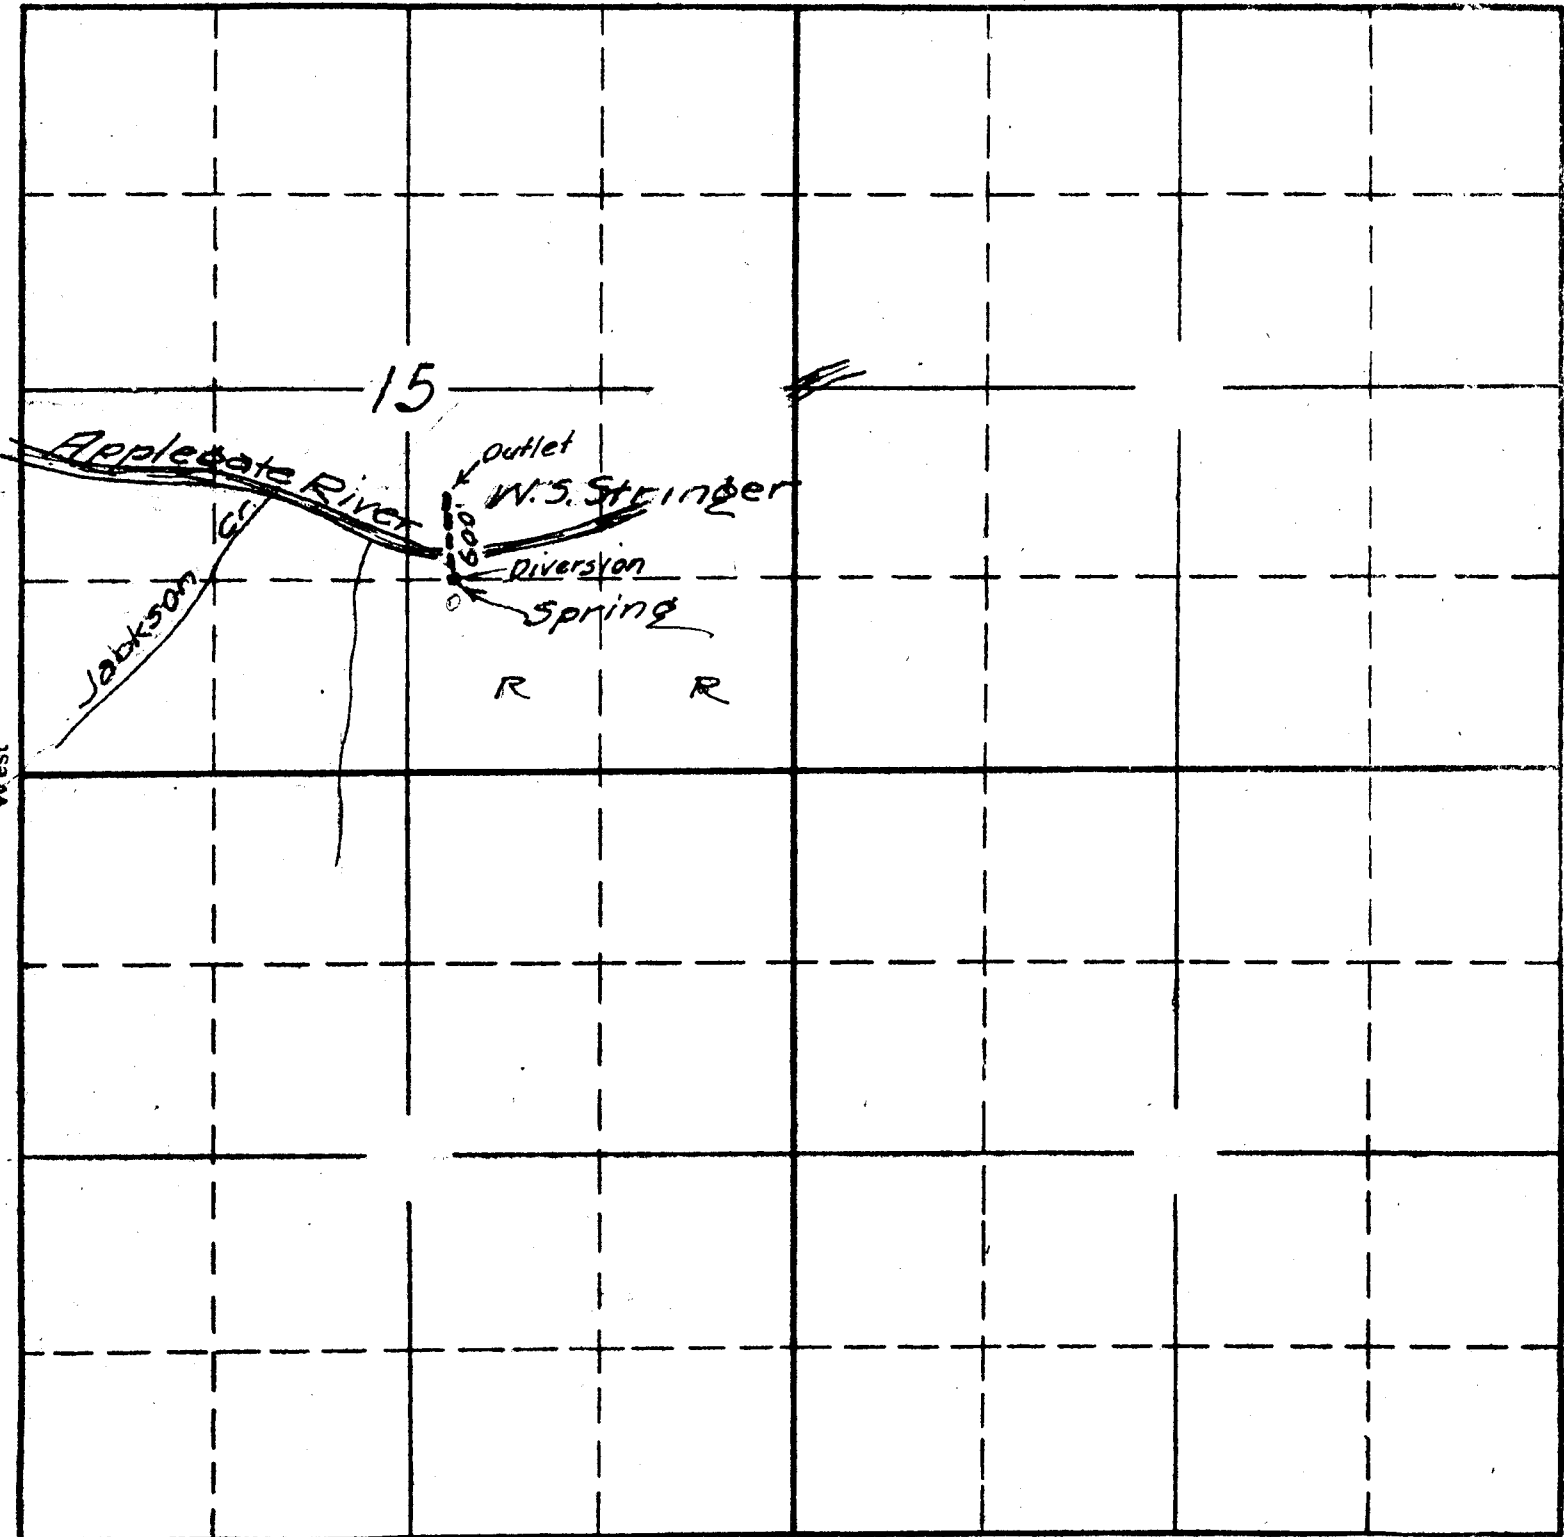


South

APPLICATION No. 13756  
 PERMIT No. 9889

SECTION  
15  
\_\_\_\_\_  
\_\_\_\_\_  
\_\_\_\_\_

TOWNSHIP 37 S, RANGE 6 W., W. M.

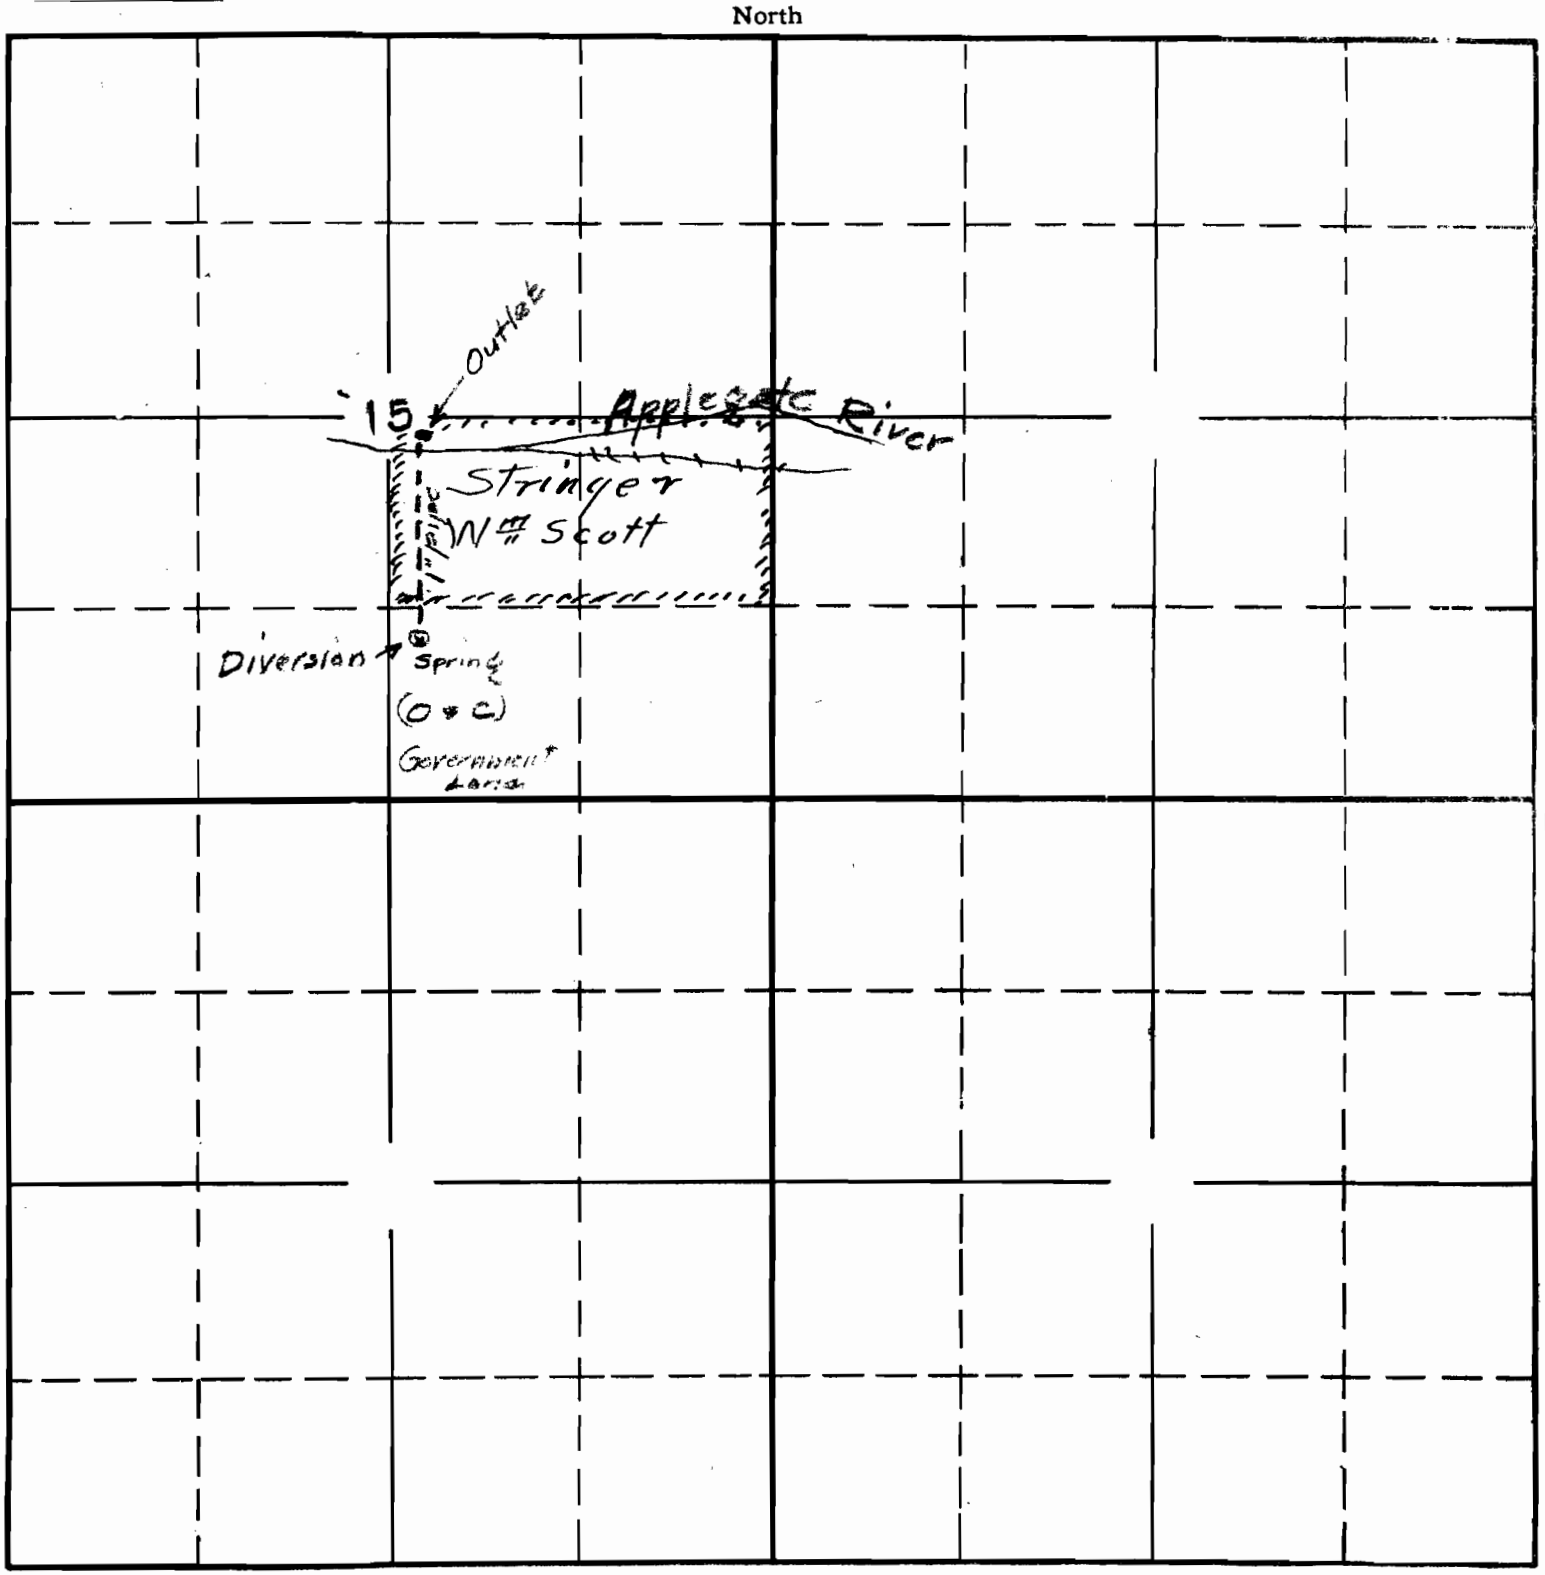

APPLICATION No. 13756  
PERMIT No. 9889