


SECTION

22  
23  
26  
27

TOWNSHIP 8, RANGE 6, W. M.

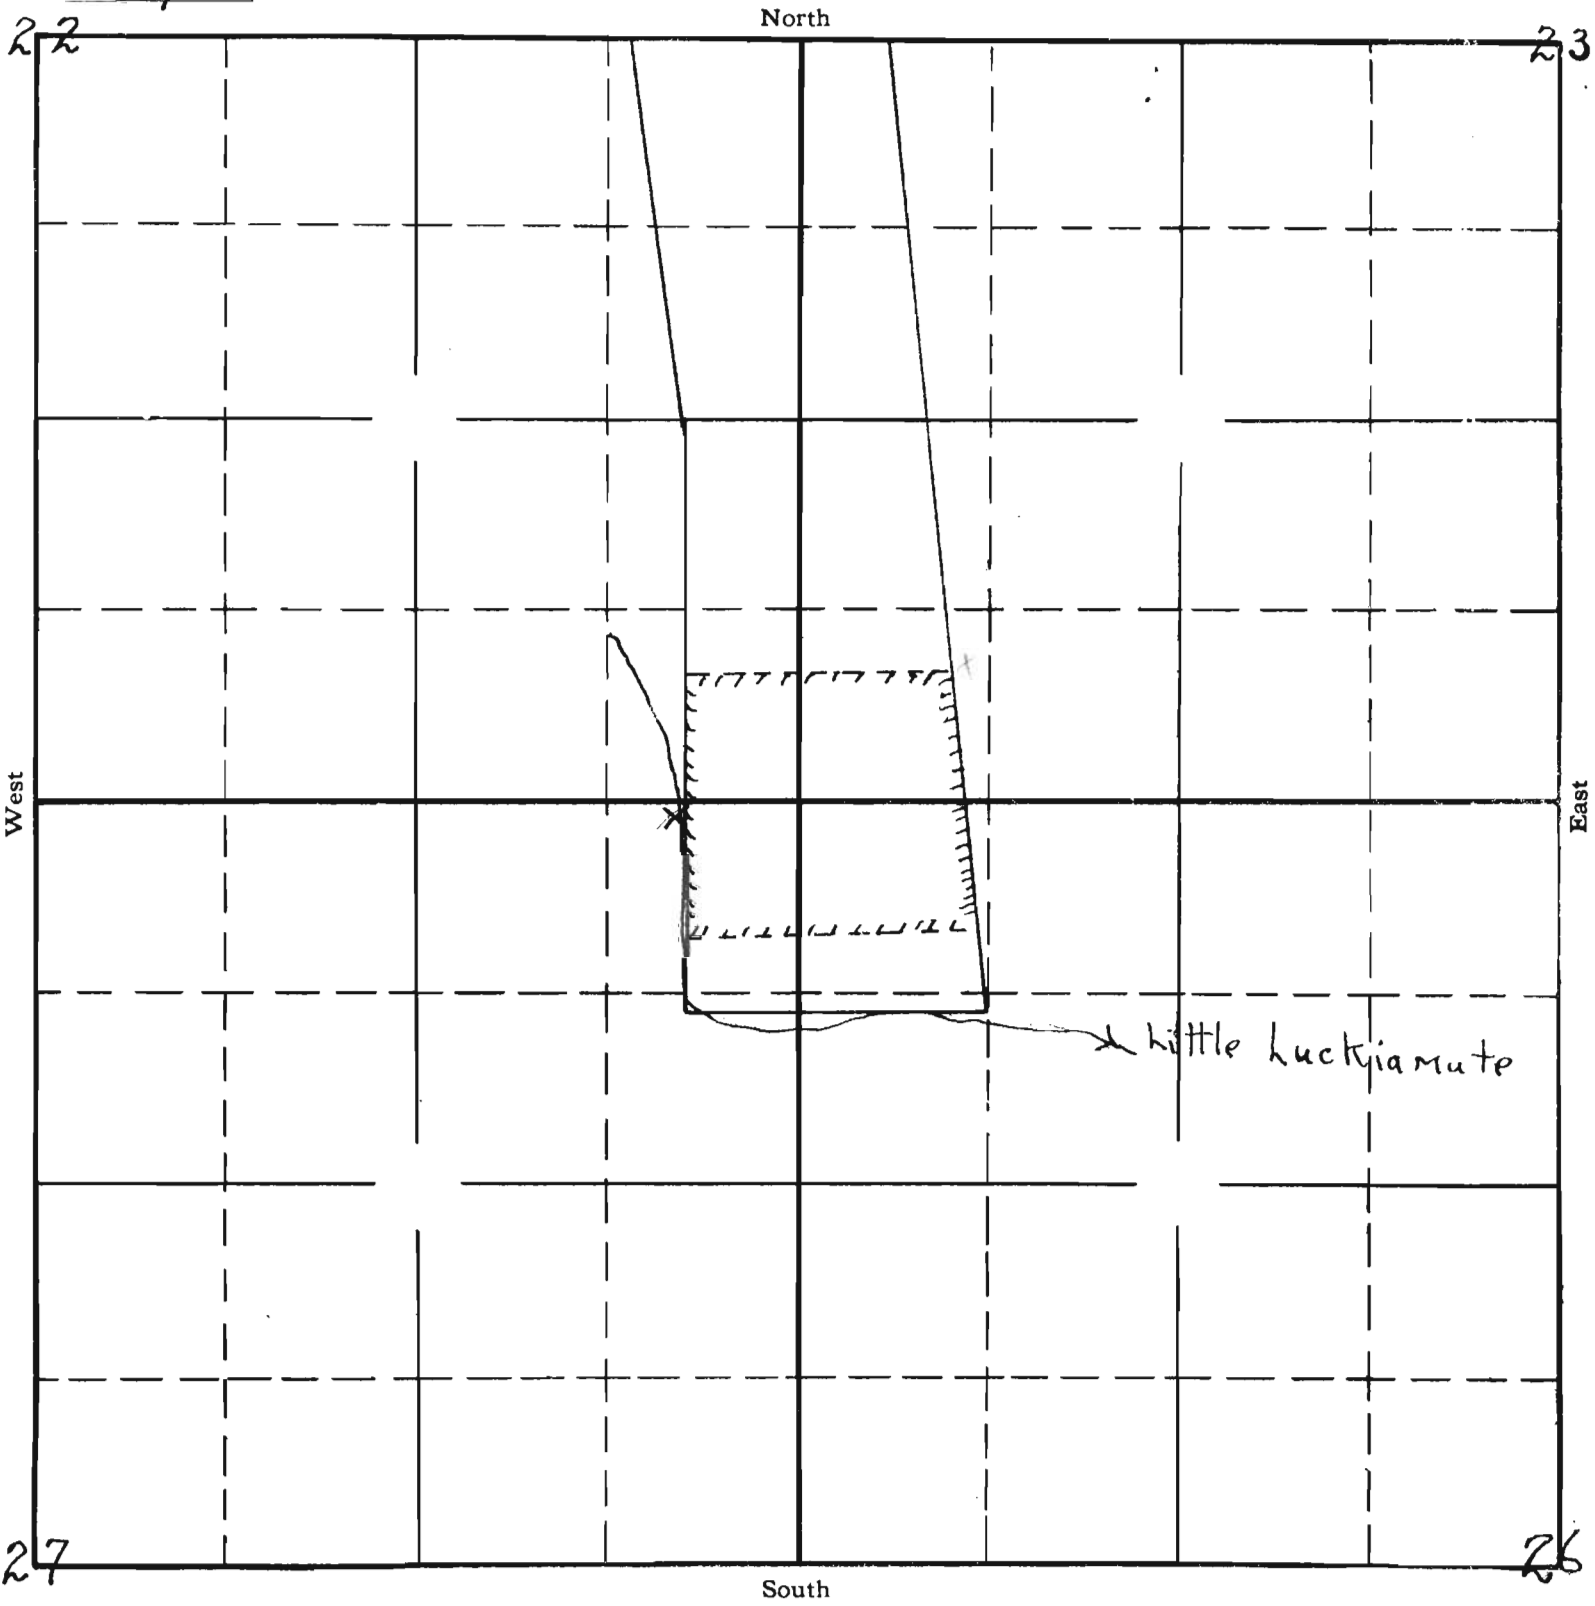

APPLICATION No. 13767  
PERMIT No. 9895

SECTION

TOWNSHIP 85, RANGE 6W, W. M.

North

22

23

Frederick Waymire  
DLC 47

Wilson Lee DLC 45



27

26

Surveyed May 31 1940 C.A.C.

South

13767  
 APPLICATION No. ~~13867~~  
 PERMIT No. 9895

West

East