
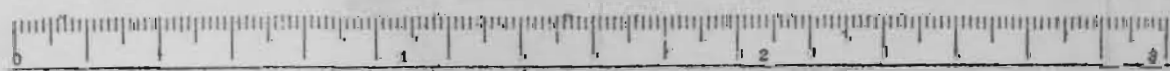


Township 35 S,

Range 4 W.

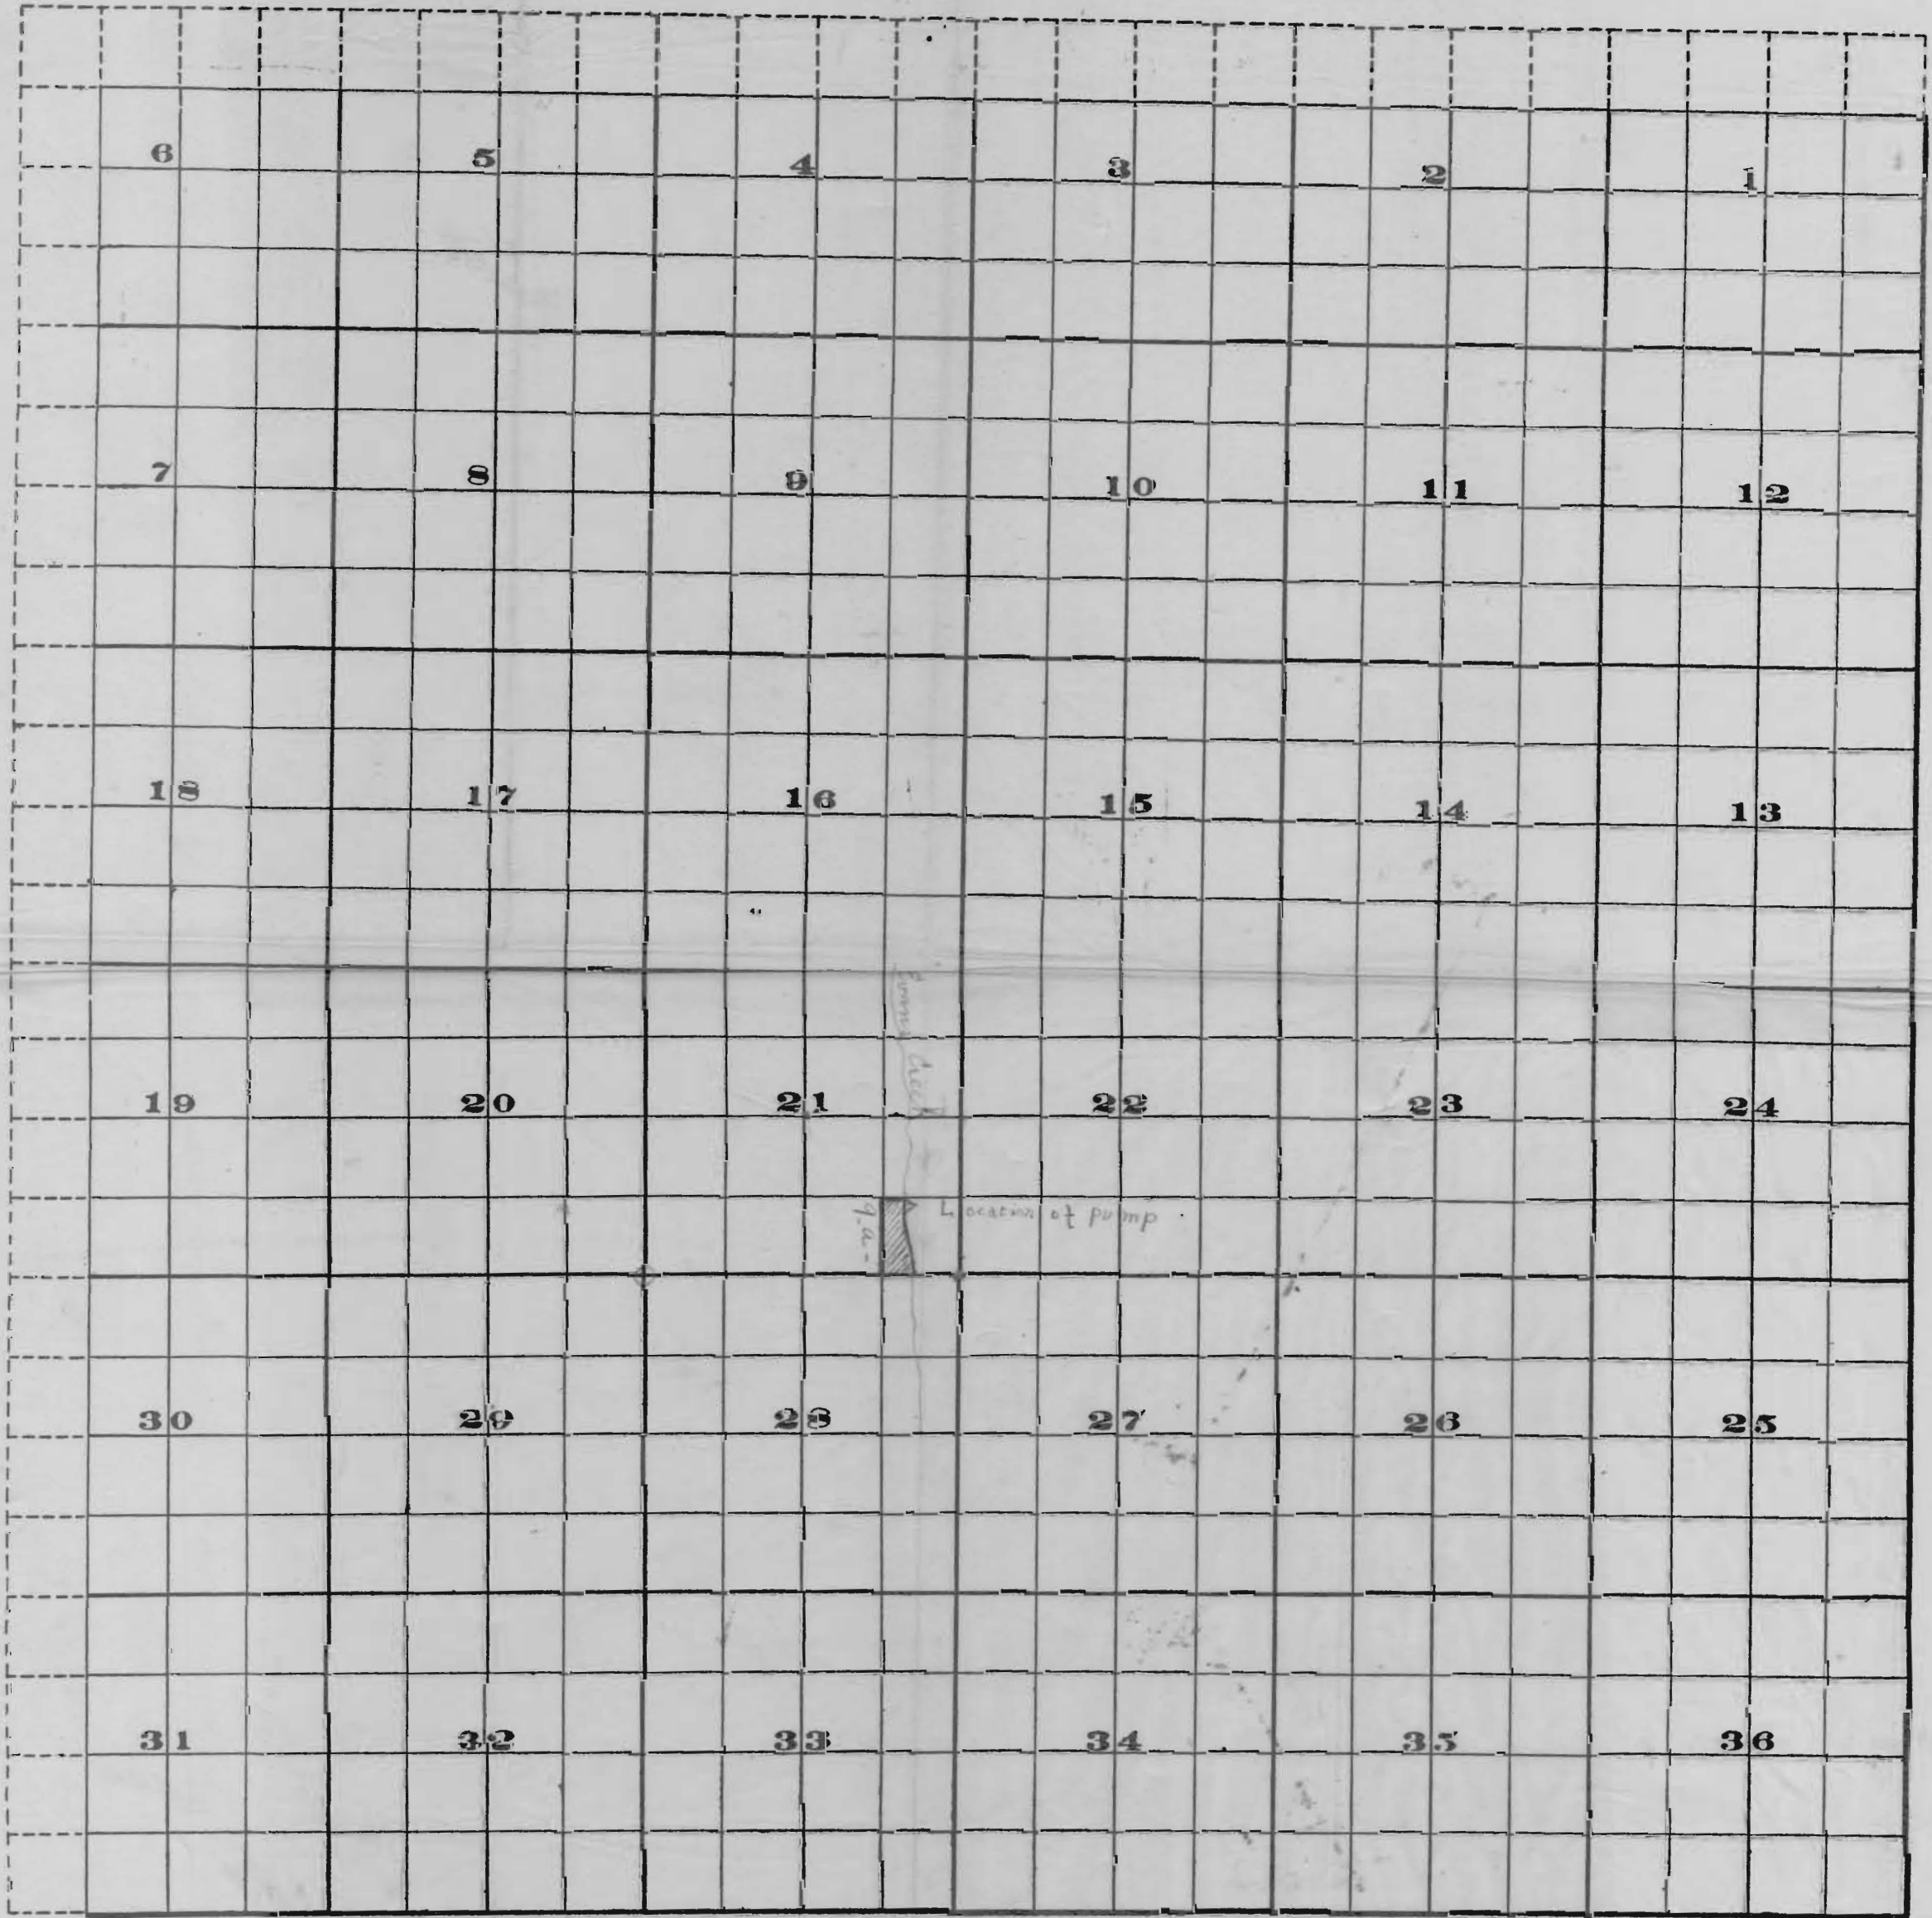

Scale of Feet.

FROM OFFICE OF THE STATE ENGINEER, SALEM, OREGON

OFFICE OF STATE ENGINEER
RECEIVED
NOV 7 1911
SALEM, OREGON

Application No. 1817
Permit No. 990