


SECTION

TOWNSHIP 7 N RANGE 3 W. W.M.

North

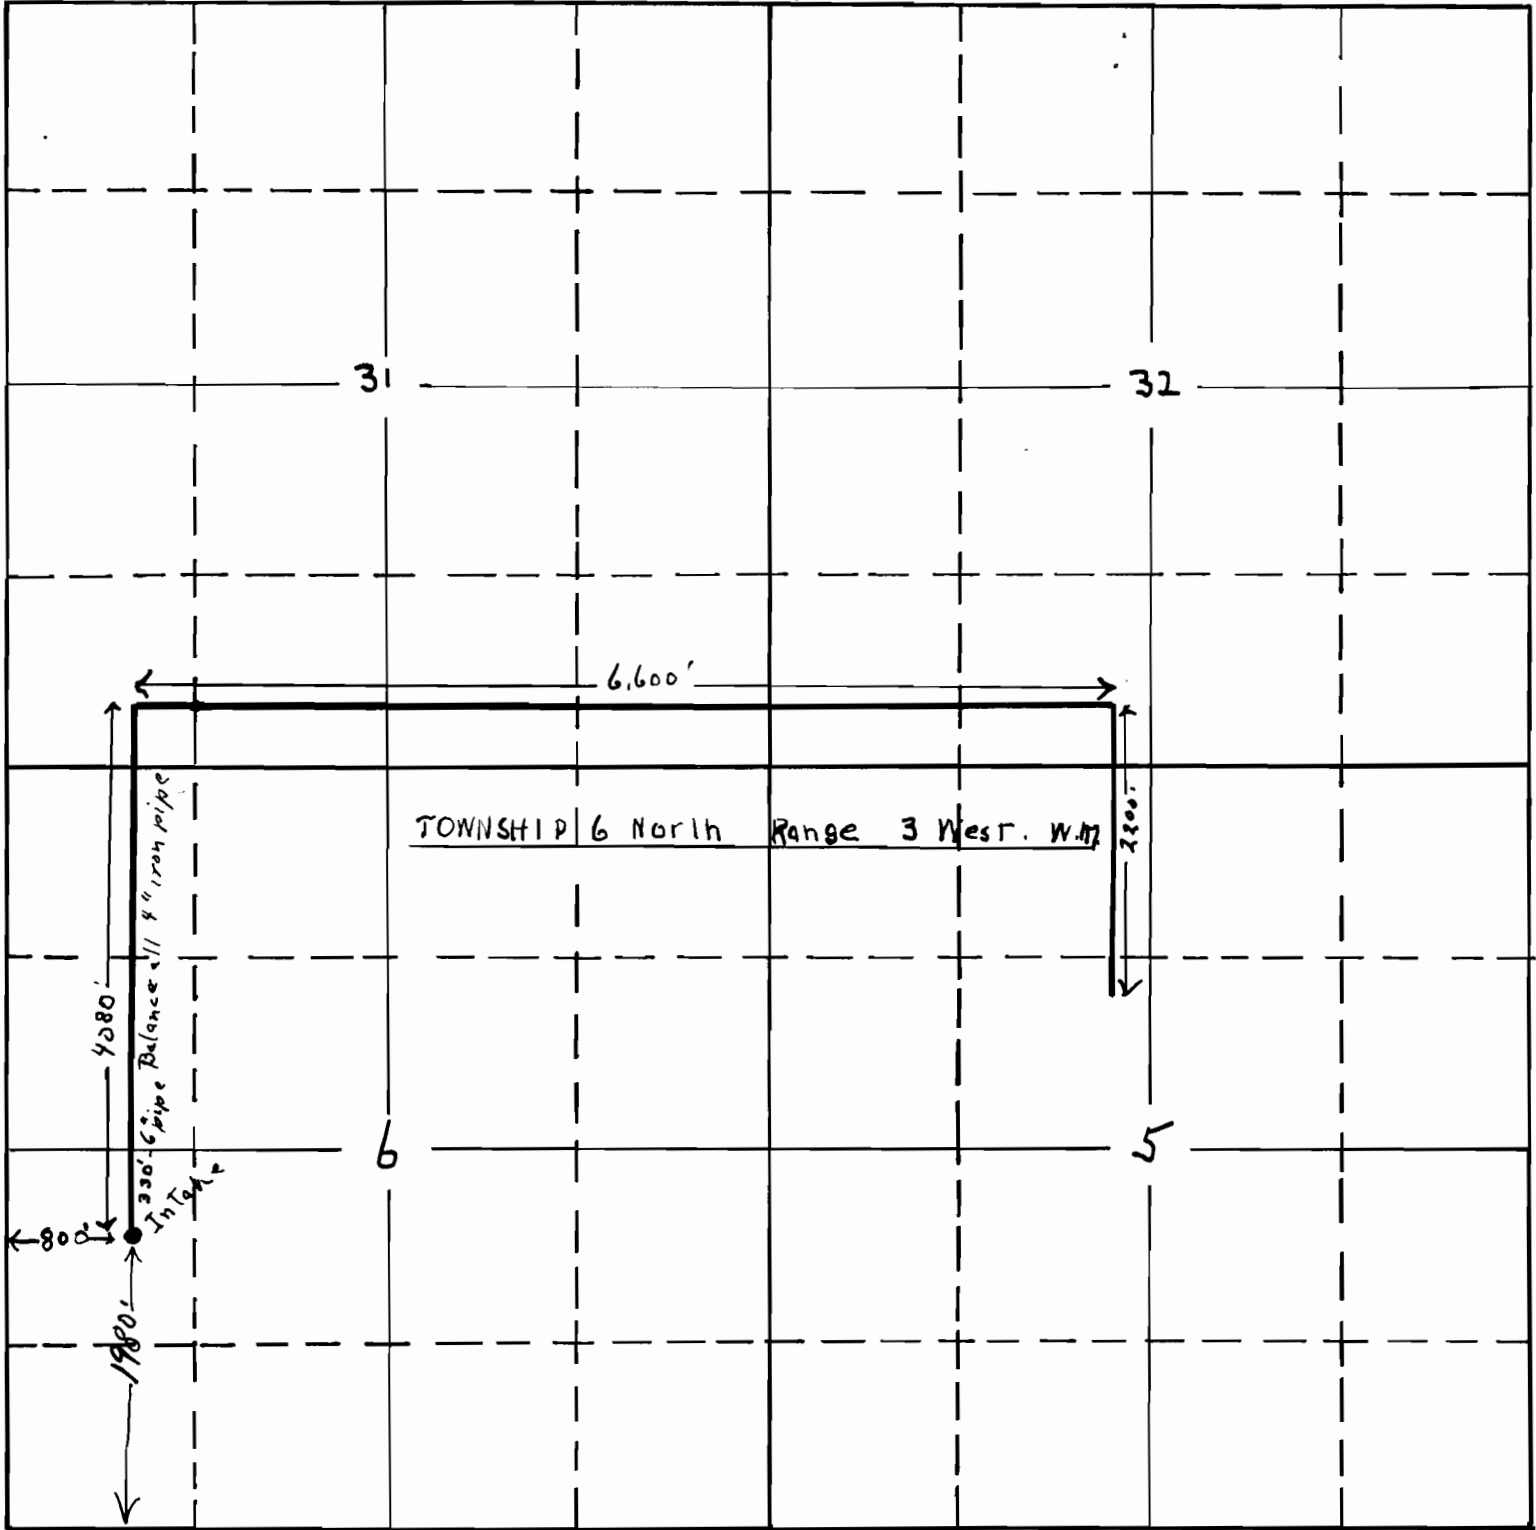

South

Benson Timber Co
Clatskanie
Oregon.

APPLICATION No. 13775
PERMIT No. 9900