


Sec. 15

Tp. 33

R. ~~ACE~~
Wm.

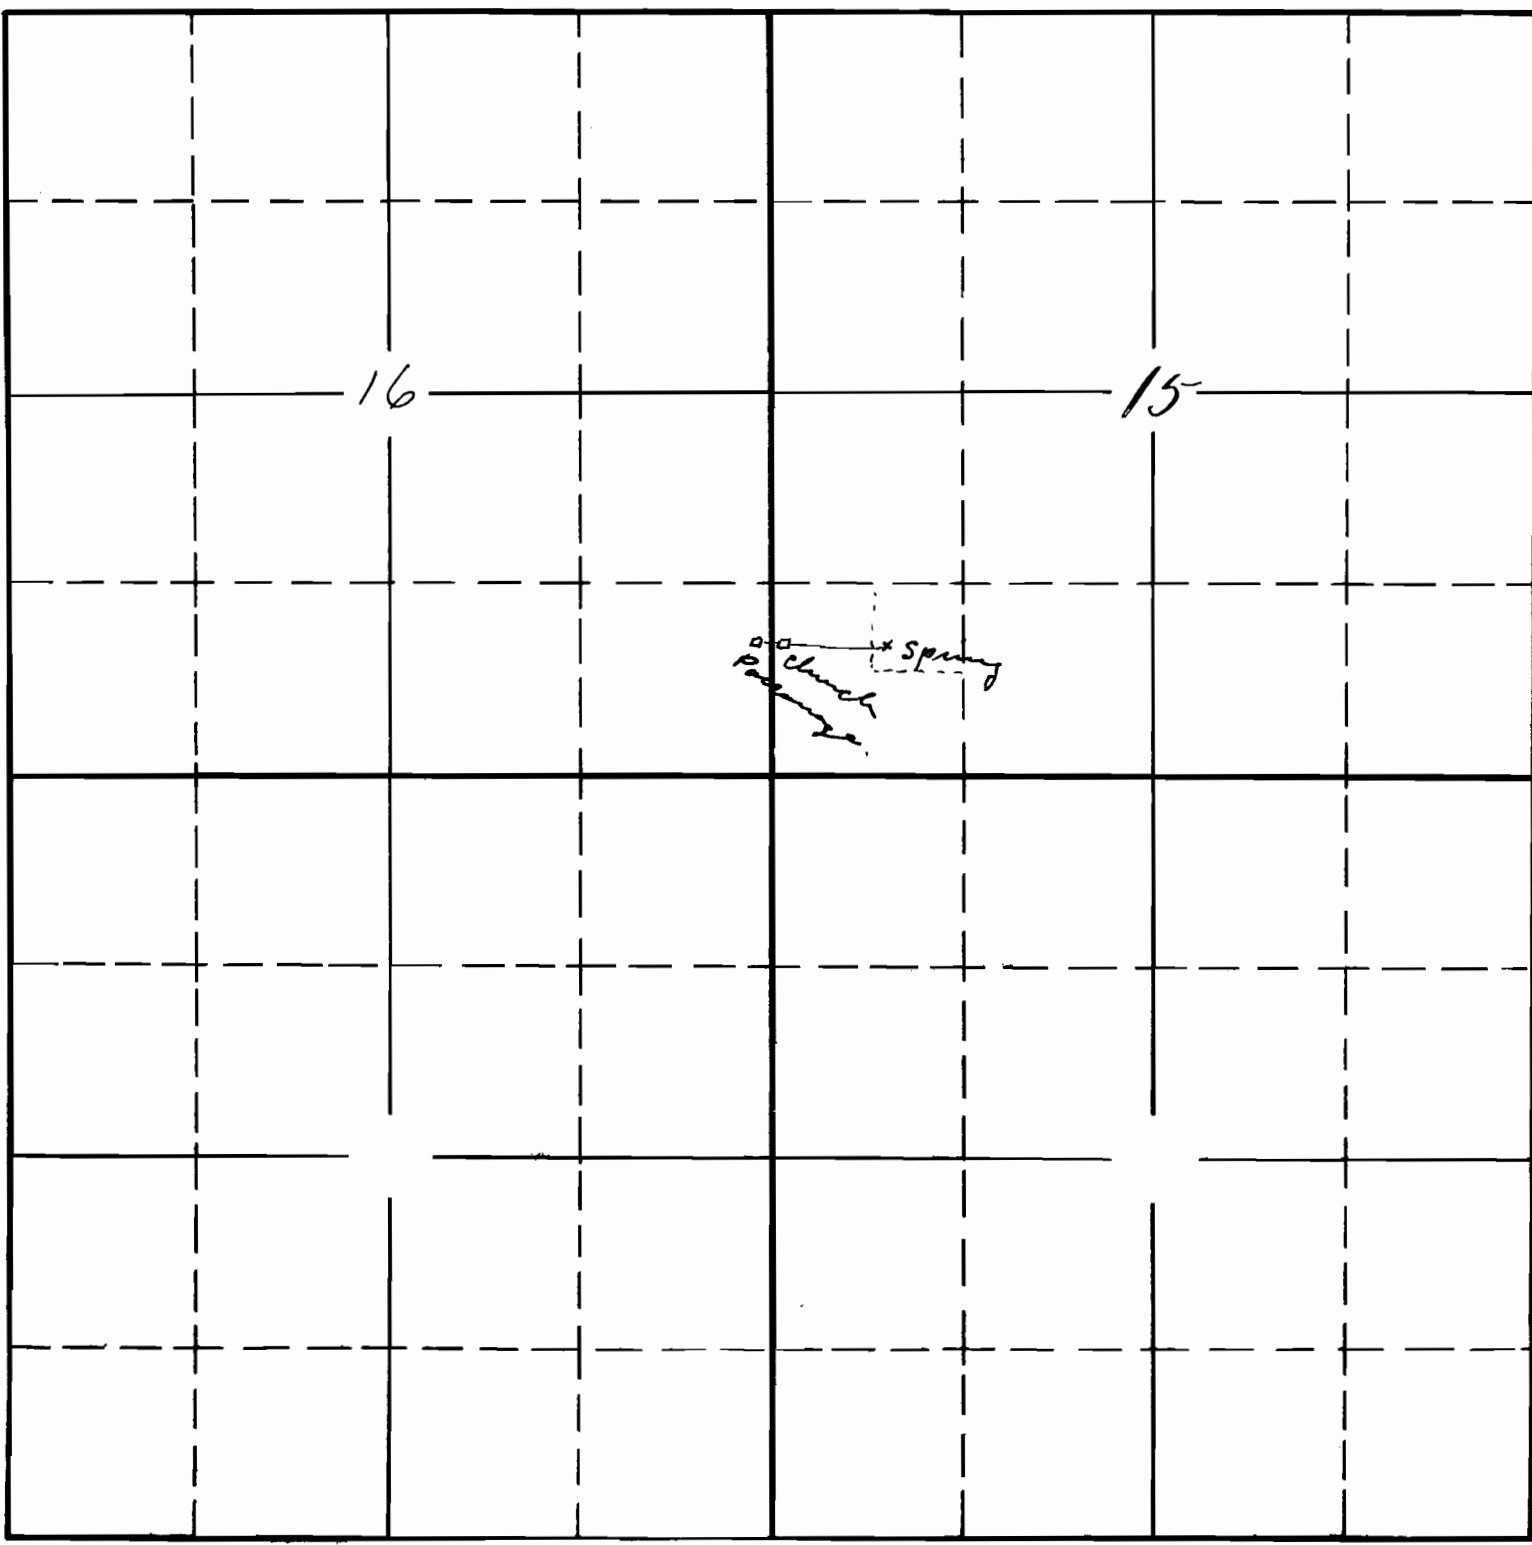

13798
99141