


SECTION

TOWNSHIP 2 S, RANGE 2 E, W. M.

North

West

East

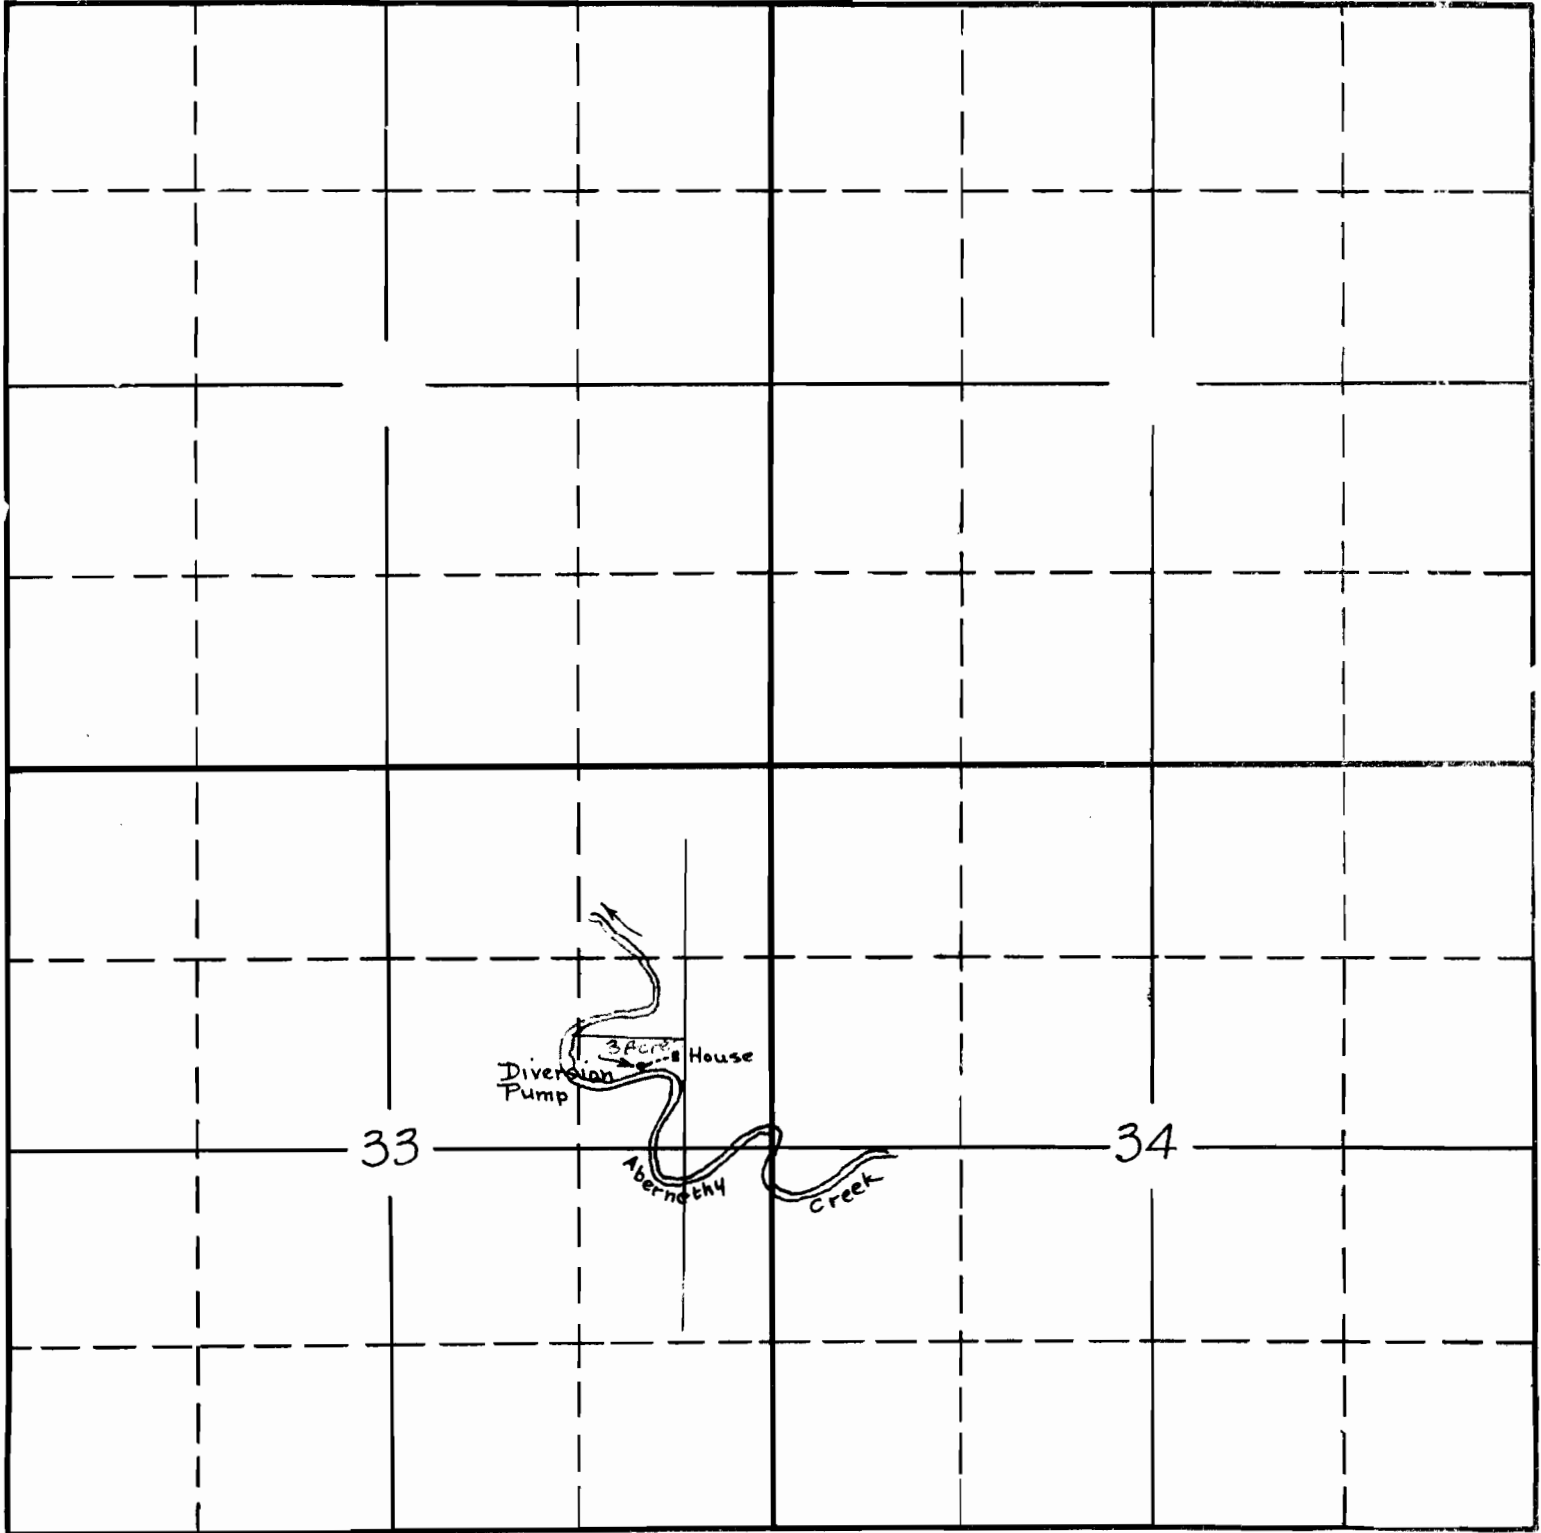

South

APPLICATION No. 13826
PERMIT No. 9057