

SECTION


5

TOWNSHIP 35, RANGE 7E, W. M.

North

West

East

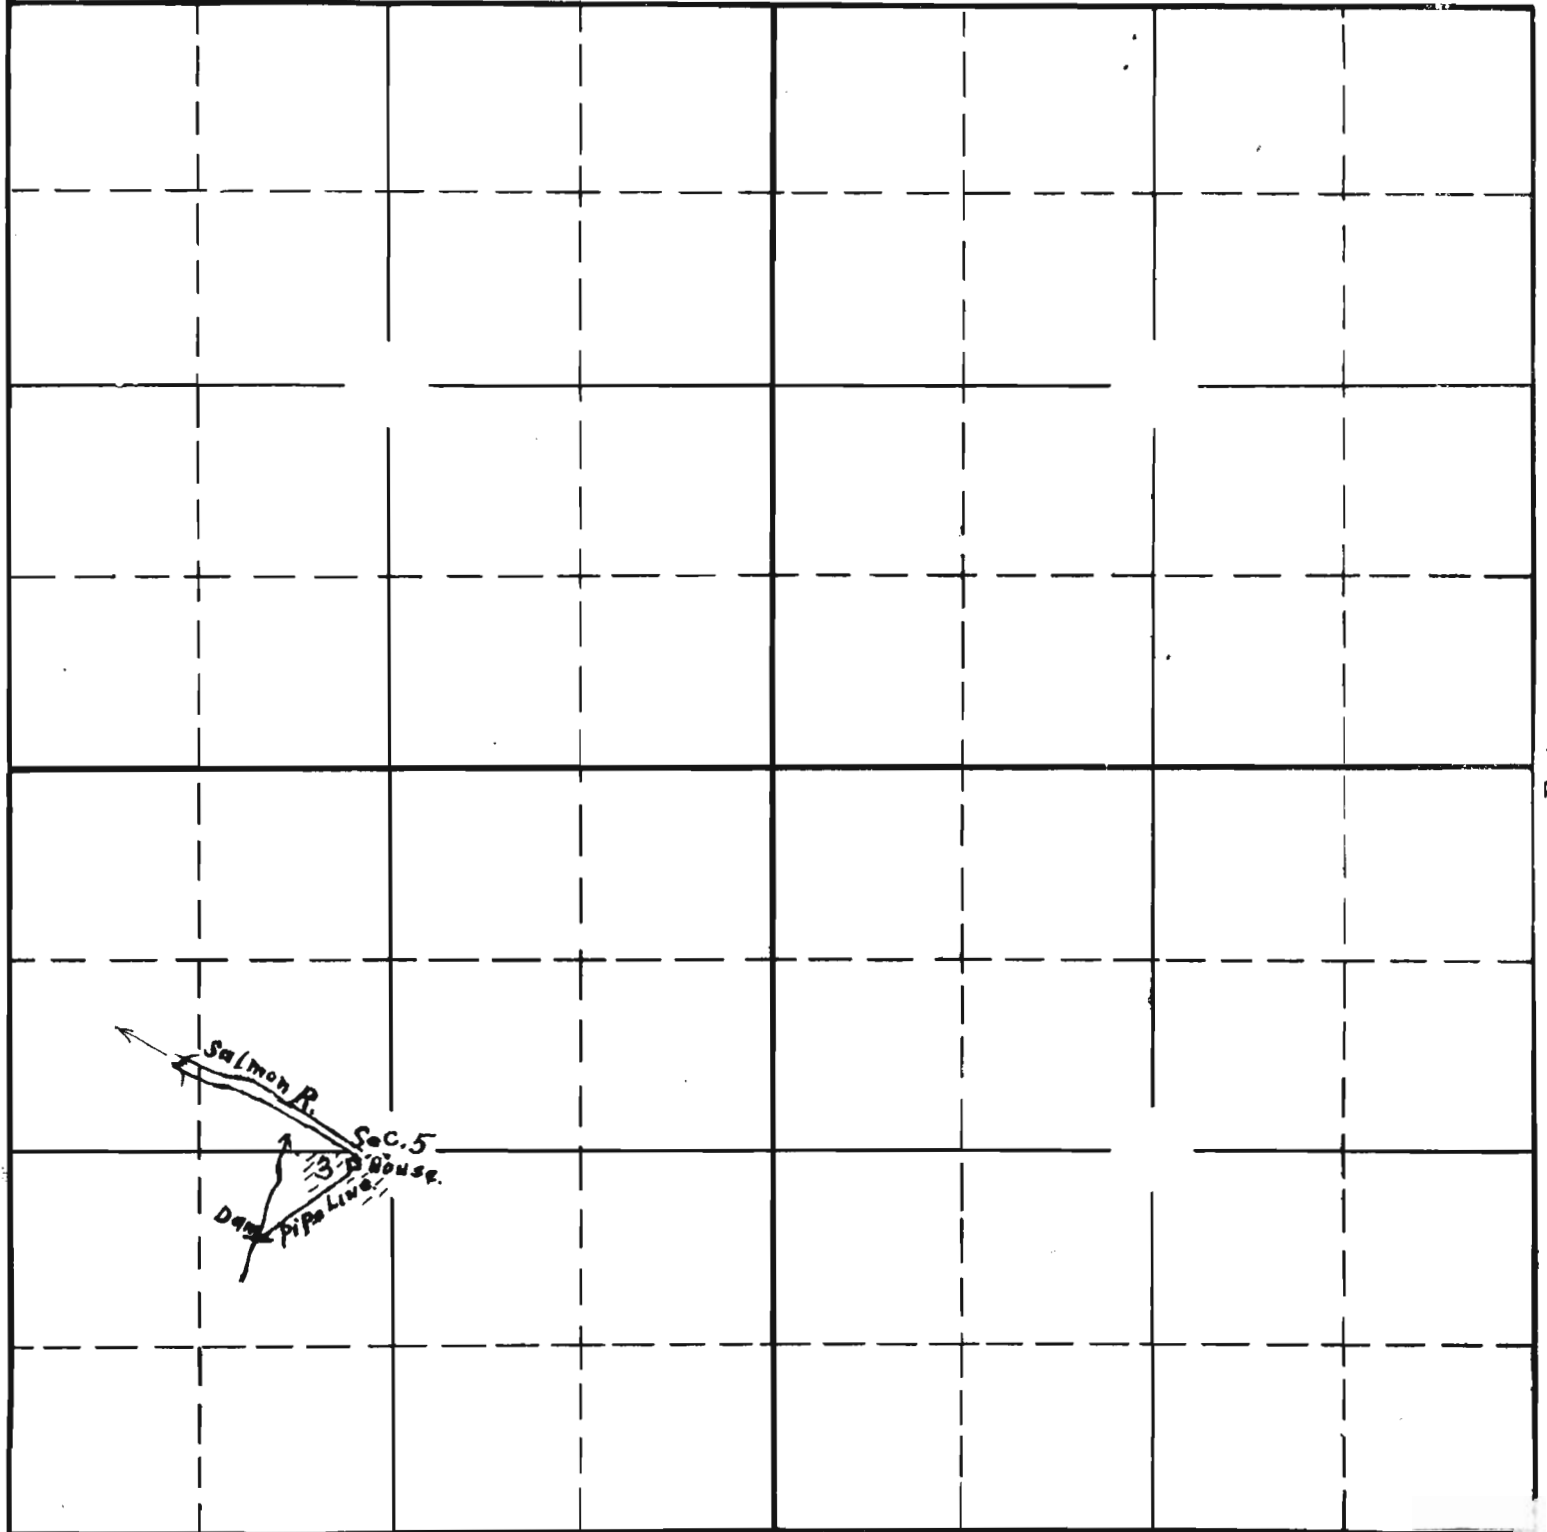

South

APPLICATION No. 13847
 PERMIT No. 9967