


Sketch  
to  
Accompany  
Water Appl.  
for  
School Dist #72  
Umatilla County  
Oregon.

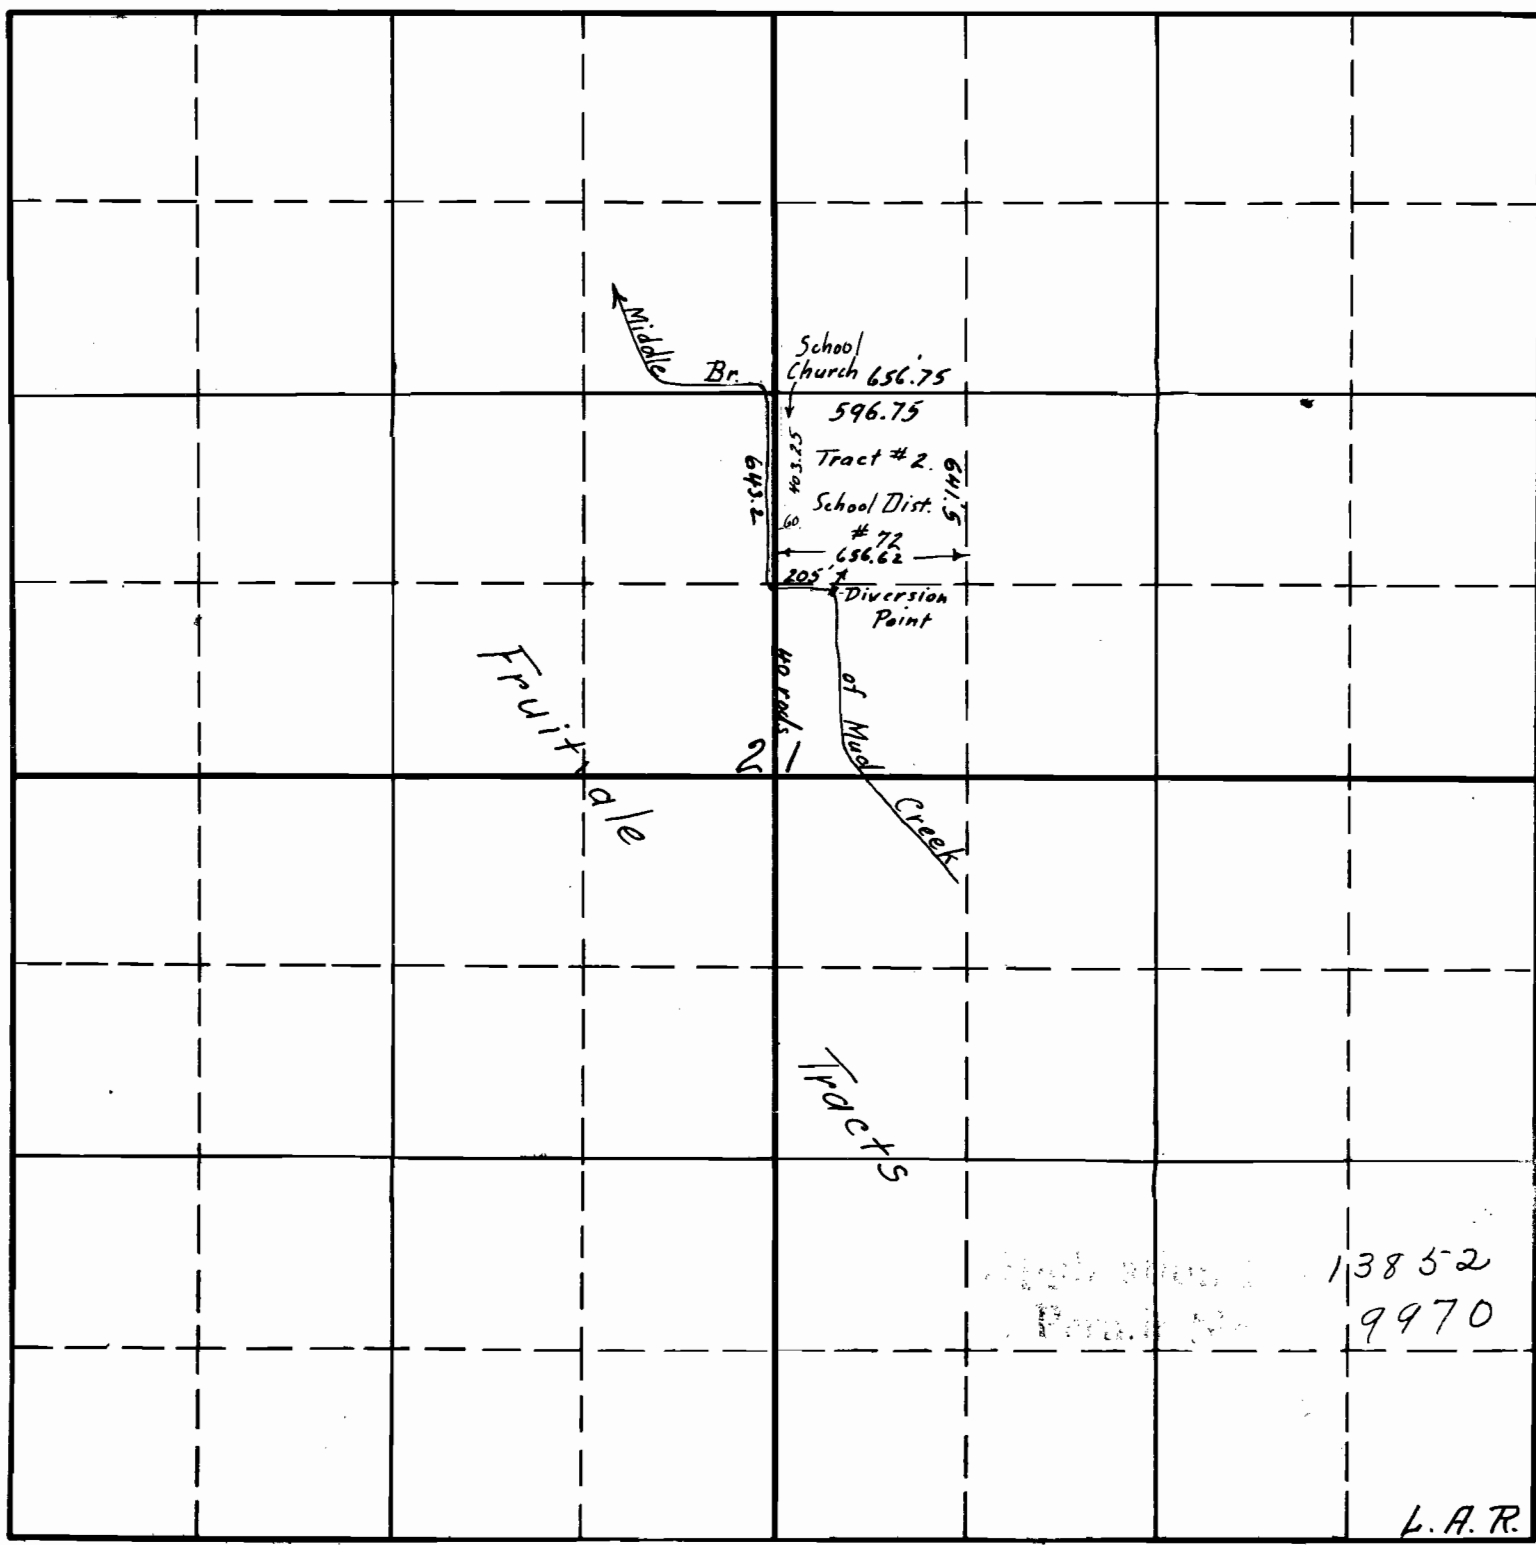

Sec. 21  
Tp. 6 N  
R. 35  
E.W.M.

11-28-30

13852  
9970

L.A.R.