


SECTION

TOWNSHIP 41S, RANGE 13W, W. M.

North

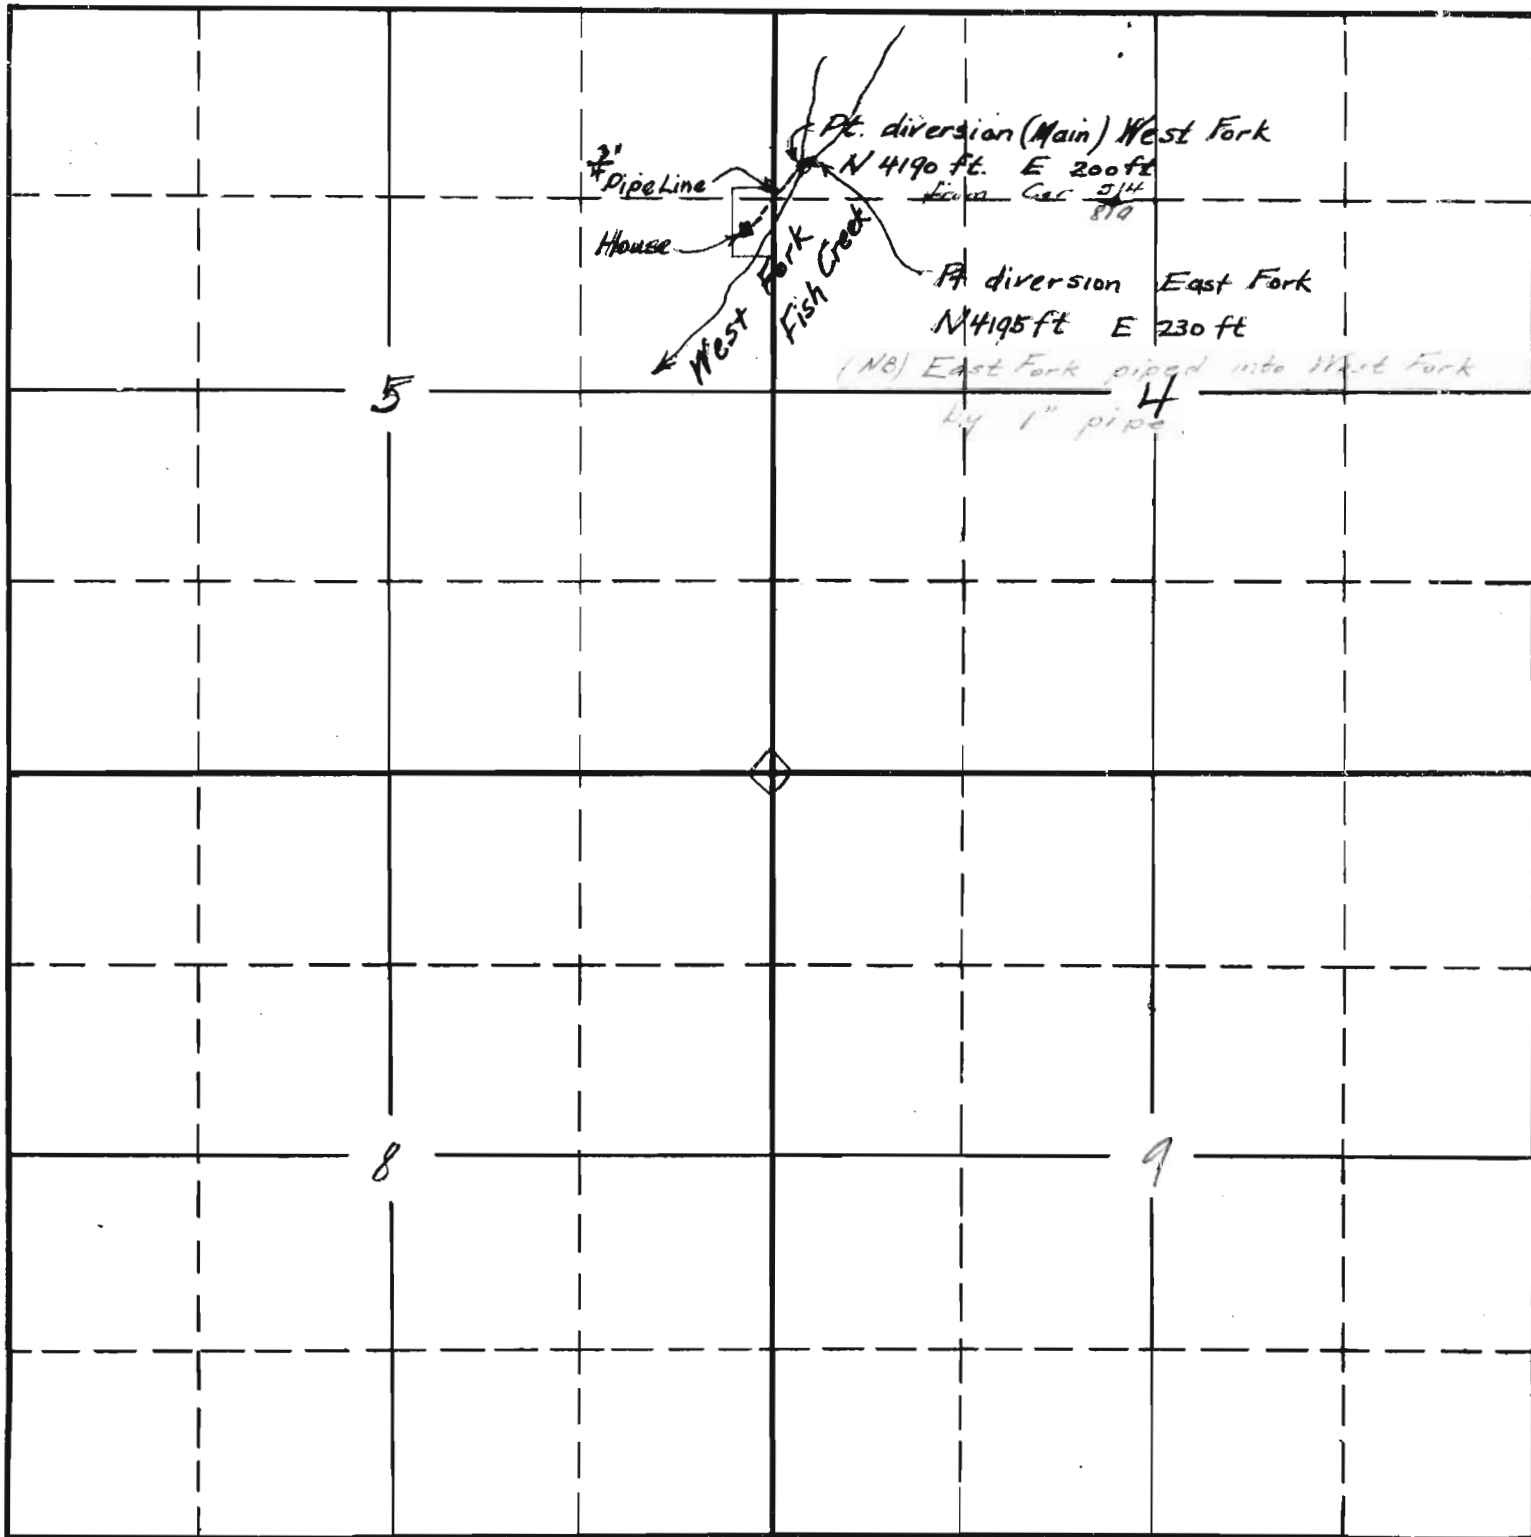

South

APPLICATION No. 13904
 PERMIT No. 9983