


TWP. 6 SOUTH R.G. 38 EAST

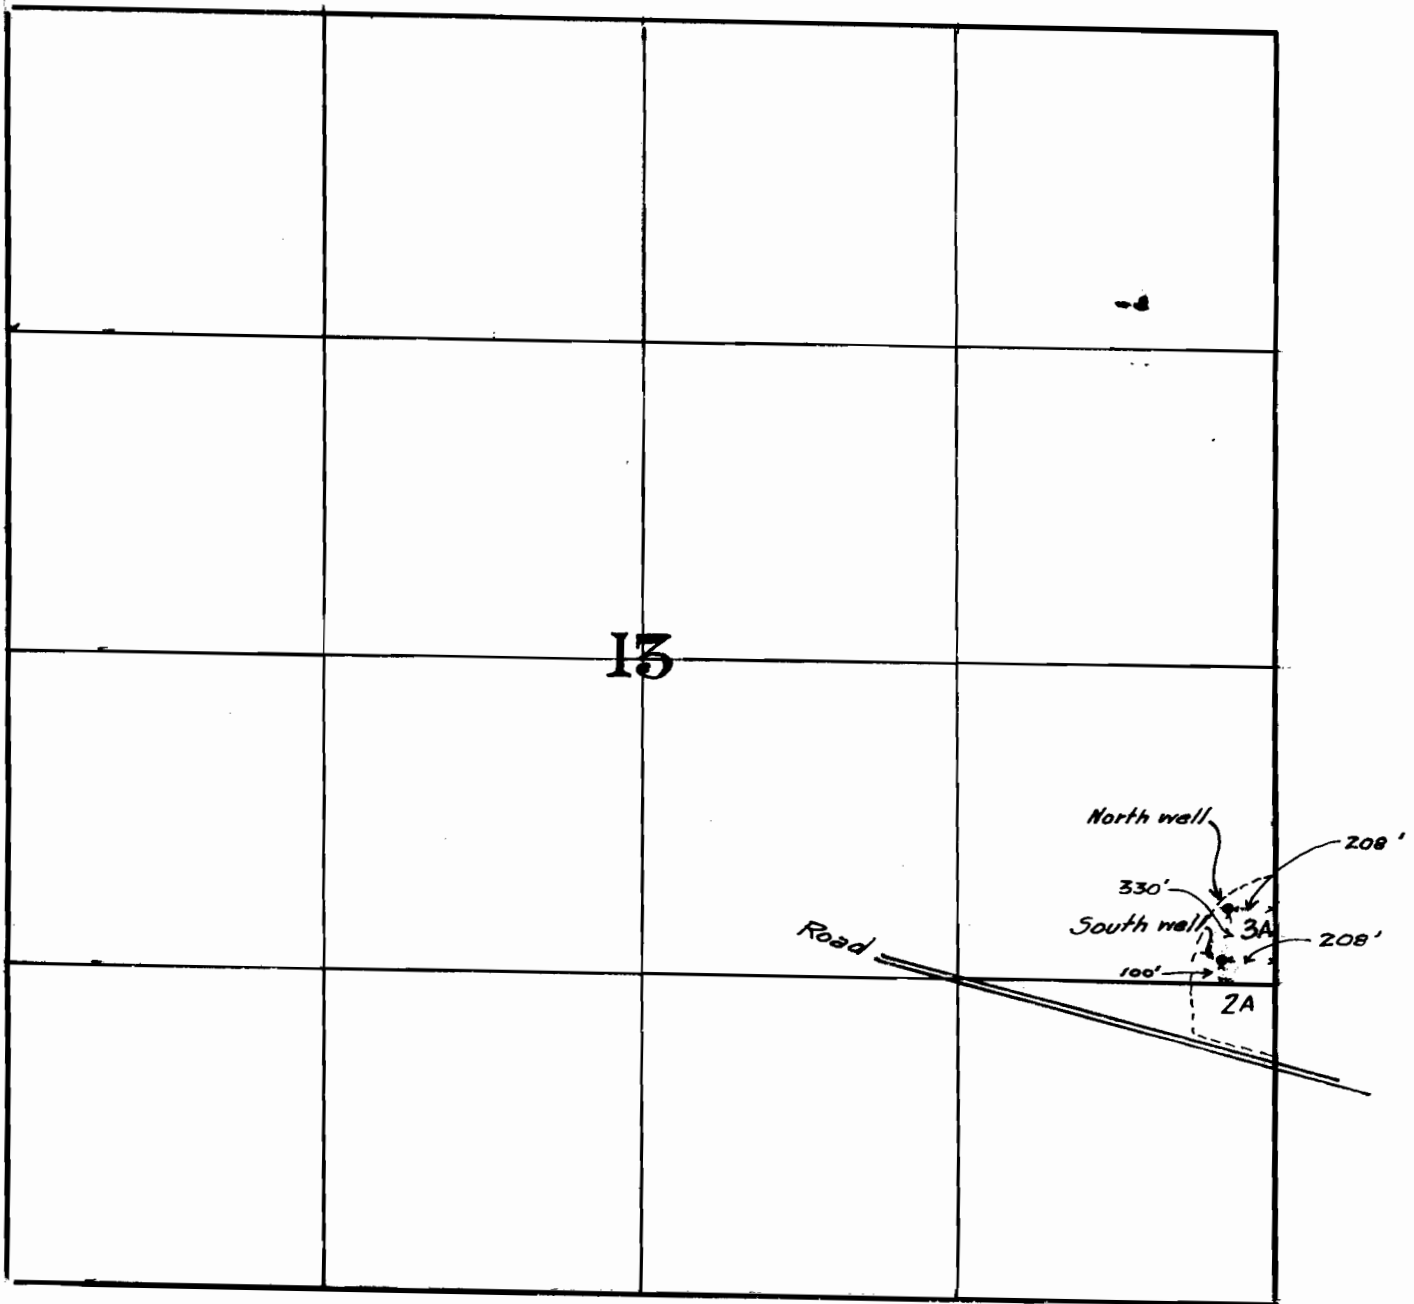

G.M. Gilkison Artesian wells

Application U 1
Permit No. U 1