


SECTION

\_\_\_\_\_  
\_\_\_\_\_  
\_\_\_\_\_  
\_\_\_\_\_

TOWNSHIP 13 S , RANGE 37 E , W. M.

North

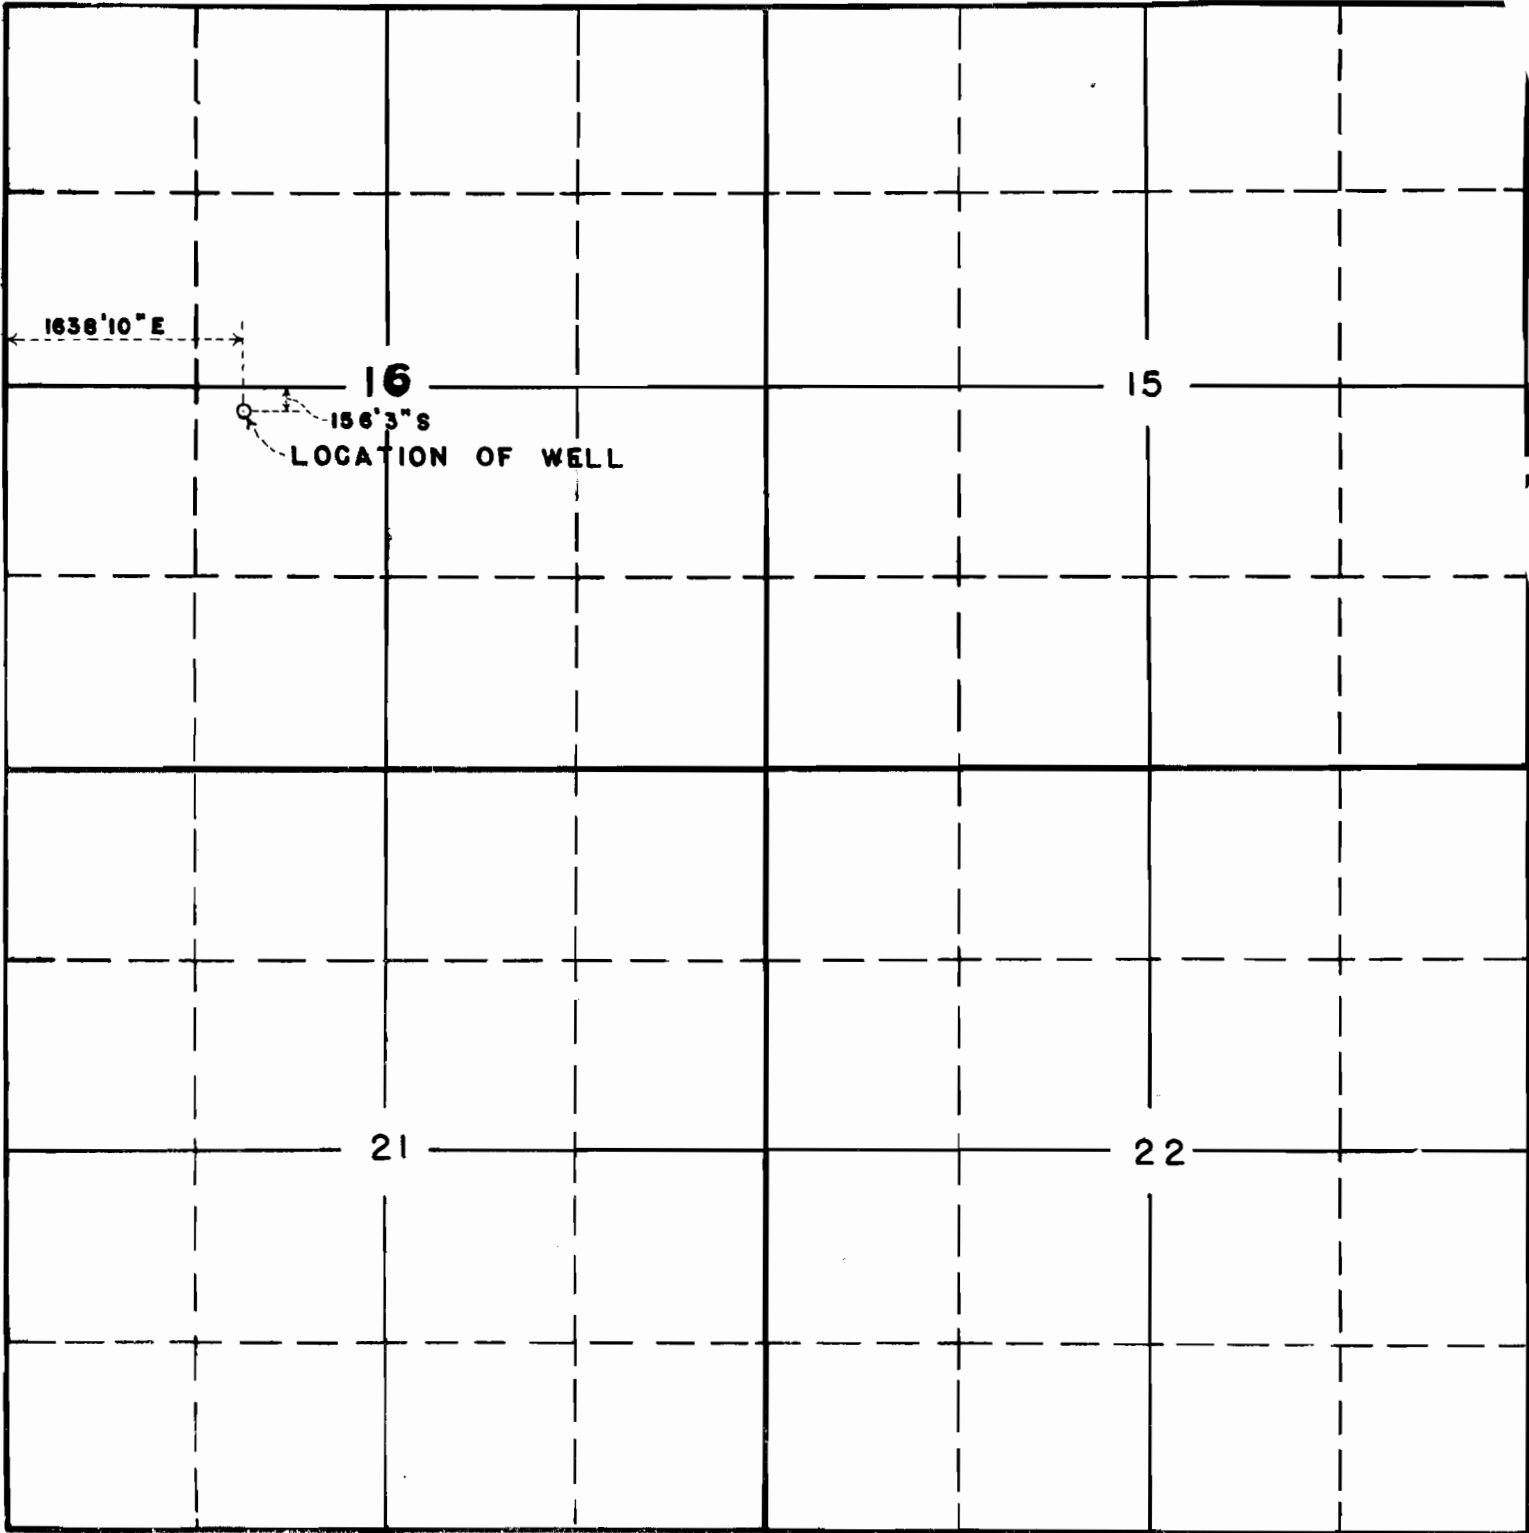

South

**RECEIVED**

OCT 28 1937

STATE ENGINEER  
SALEM, OREGON

APPLICATION No. *U-110*

PERMIT No. *U-103*